


ARCHITECT OF RECORD

ARCHITECT - PAUL C. GLORIOT


CONSULTANT

100 South Anaheim Boulevard, Suite 150
Anaheim, California 92805
Phone: 714.490.5555 Fax: 714.490.5560
Project No. 2305-163-07

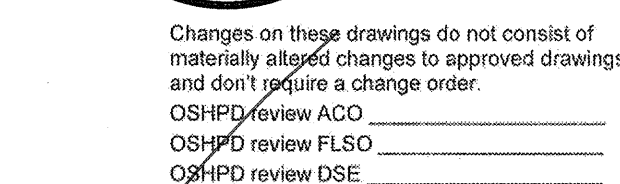

REVISIONS

APPROVAL

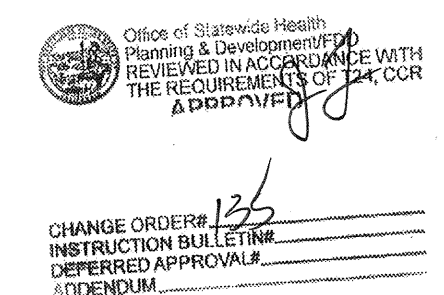

PROJECT NAME

455 S. Main St.
Orange, CA 92868-3874

RECEIVED
SEPT. 21 2011
McCARTHY

 **CHOC**SM
HOSPITAL

PROJECT NUMBER

OSHPD - PROJECT NUMBER
IL 072072-30

ISSUE

OSHPD PERMIT

DATE _____

01/27/2010

SCALE

NONE

NONE
DRAWING TITLE

SHEET INDEX
VOLUME 4A

DRAWING NUMBER

M0.01B

T: \\23CAD\\2305\\2305-163-07\\NC-7_M-P\\M0_01B.DWG
9/13/2011
AHERNANDEZ