

FKP Architects

ARCHITECT OF RECORD

*Architect of Record signature line only; this drawing was not prepared under the direct supervision of the Architect of Record. The direct responsibility for preparation of this sheet lies with its corresponding professional stamp and signature. The signature of the Architect of Record in general responsible charge of the project is provided as required by Title 24, Part 1, Section 7-115 (a).

ARCHITECT - PAUL C. GLORIOD

CONSULTANT

T M A D
TAYLOR & GAINES

- STRUCTURAL
- MECHANICAL
- ELECTRICAL
- CIVIL

100 South Anaheim Boulevard, Suite 150
Anaheim, California 92805
Phone: 714.490.5555 Fax: 714.490.5560
Project No. 2305-163-07




Changes on these drawings do not consist of materially altered changes to approved drawings and don't require Change Order.
OSHDP review ACO
OSHDP review FLSO
OSHDP review DSE

REVISIONS

04/15/2011 CHANGE ORDER #135
01/30/2012 CHANGE ORDER #320

| | | | |
|---------------------------------|-------------|----|---|
| OSHDP/DSE-Field Review Tracking | | | |
| Project | 2012-012451 | | |
| Rev | 2012 | | |
| Architectural | A | AC | D |
| Mechanical | A | AC | D |
| Electrical | A | AC | D |
| DSE | A | AC | D |
| FLSO | A | AC | D |
| Fire Life Safety | A | AC | D |

APPROVAL

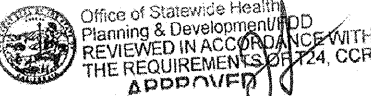

CHANGE ORDER 320
INSTRUCTION BLANKET
OFFERED APPROVAL
INDEMNITY

PROJECT NAME

CHILDREN'S HOSPITAL
OF ORANGE COUNTY
455 S. Main St.
Orange, CA 92868-3874

TOWER II



PROJECT NUMBER

12011.00
Increment #7

OSHDP - PROJECT NUMBER

IL 072072-30

ISSUE

OSHDP PERMIT

DATE

01/27/2010

SCALE

NONE

DRAWING TITLE

SHEET INDEX
VOLUME 4A

DRAWING NUMBER

M0.01C



E

D

C

B

A

6

5

4

3

2

1