

FKP Architects

ARCHITECT OF RECORD

"Architect of Record signature line only; this drawing was not prepared under the direct supervision of the Architect of Record. The direct responsibility for preparation of this sheet lies with its corresponding professional stamp and signature. The signature of the Architect of Record in general responsible charge of the project is provided as required by Title 24, Part 1, Section 7-115 (a)." ARCHITECT - PAUL C. GLORIOT

CONSULTANT

T M A D
TAYLOR
& GAINES

100 South Anaheim Boulevard, Suite 150
Anaheim, California 92805
Phone: 714.490.5555 Fax: 714.490.5560
Project No: 2305-163-07



REVISIONS

09/02/09 ISSUED FOR FGMP
09/14/2010 CHANGE ORDER #26

APPROVAL



PROJECT NAME
CHILDREN'S HOSPITAL
OF ORANGE COUNTY
455 S. Main St.
Orange, CA 92668-3874

TOWER II



PROJECT NUMBER

12011.00
Increment #7

OSHPD - PROJECT NUMBER
IL 072072-30

ISSUE

OSHPD PERMIT

DATE

01/27/2010


SCALE

DRAWING TITLE


MECHANICAL DETAILS -
DUCT SUPPORT DETAILS

DRAWING NUMBER


M10.05

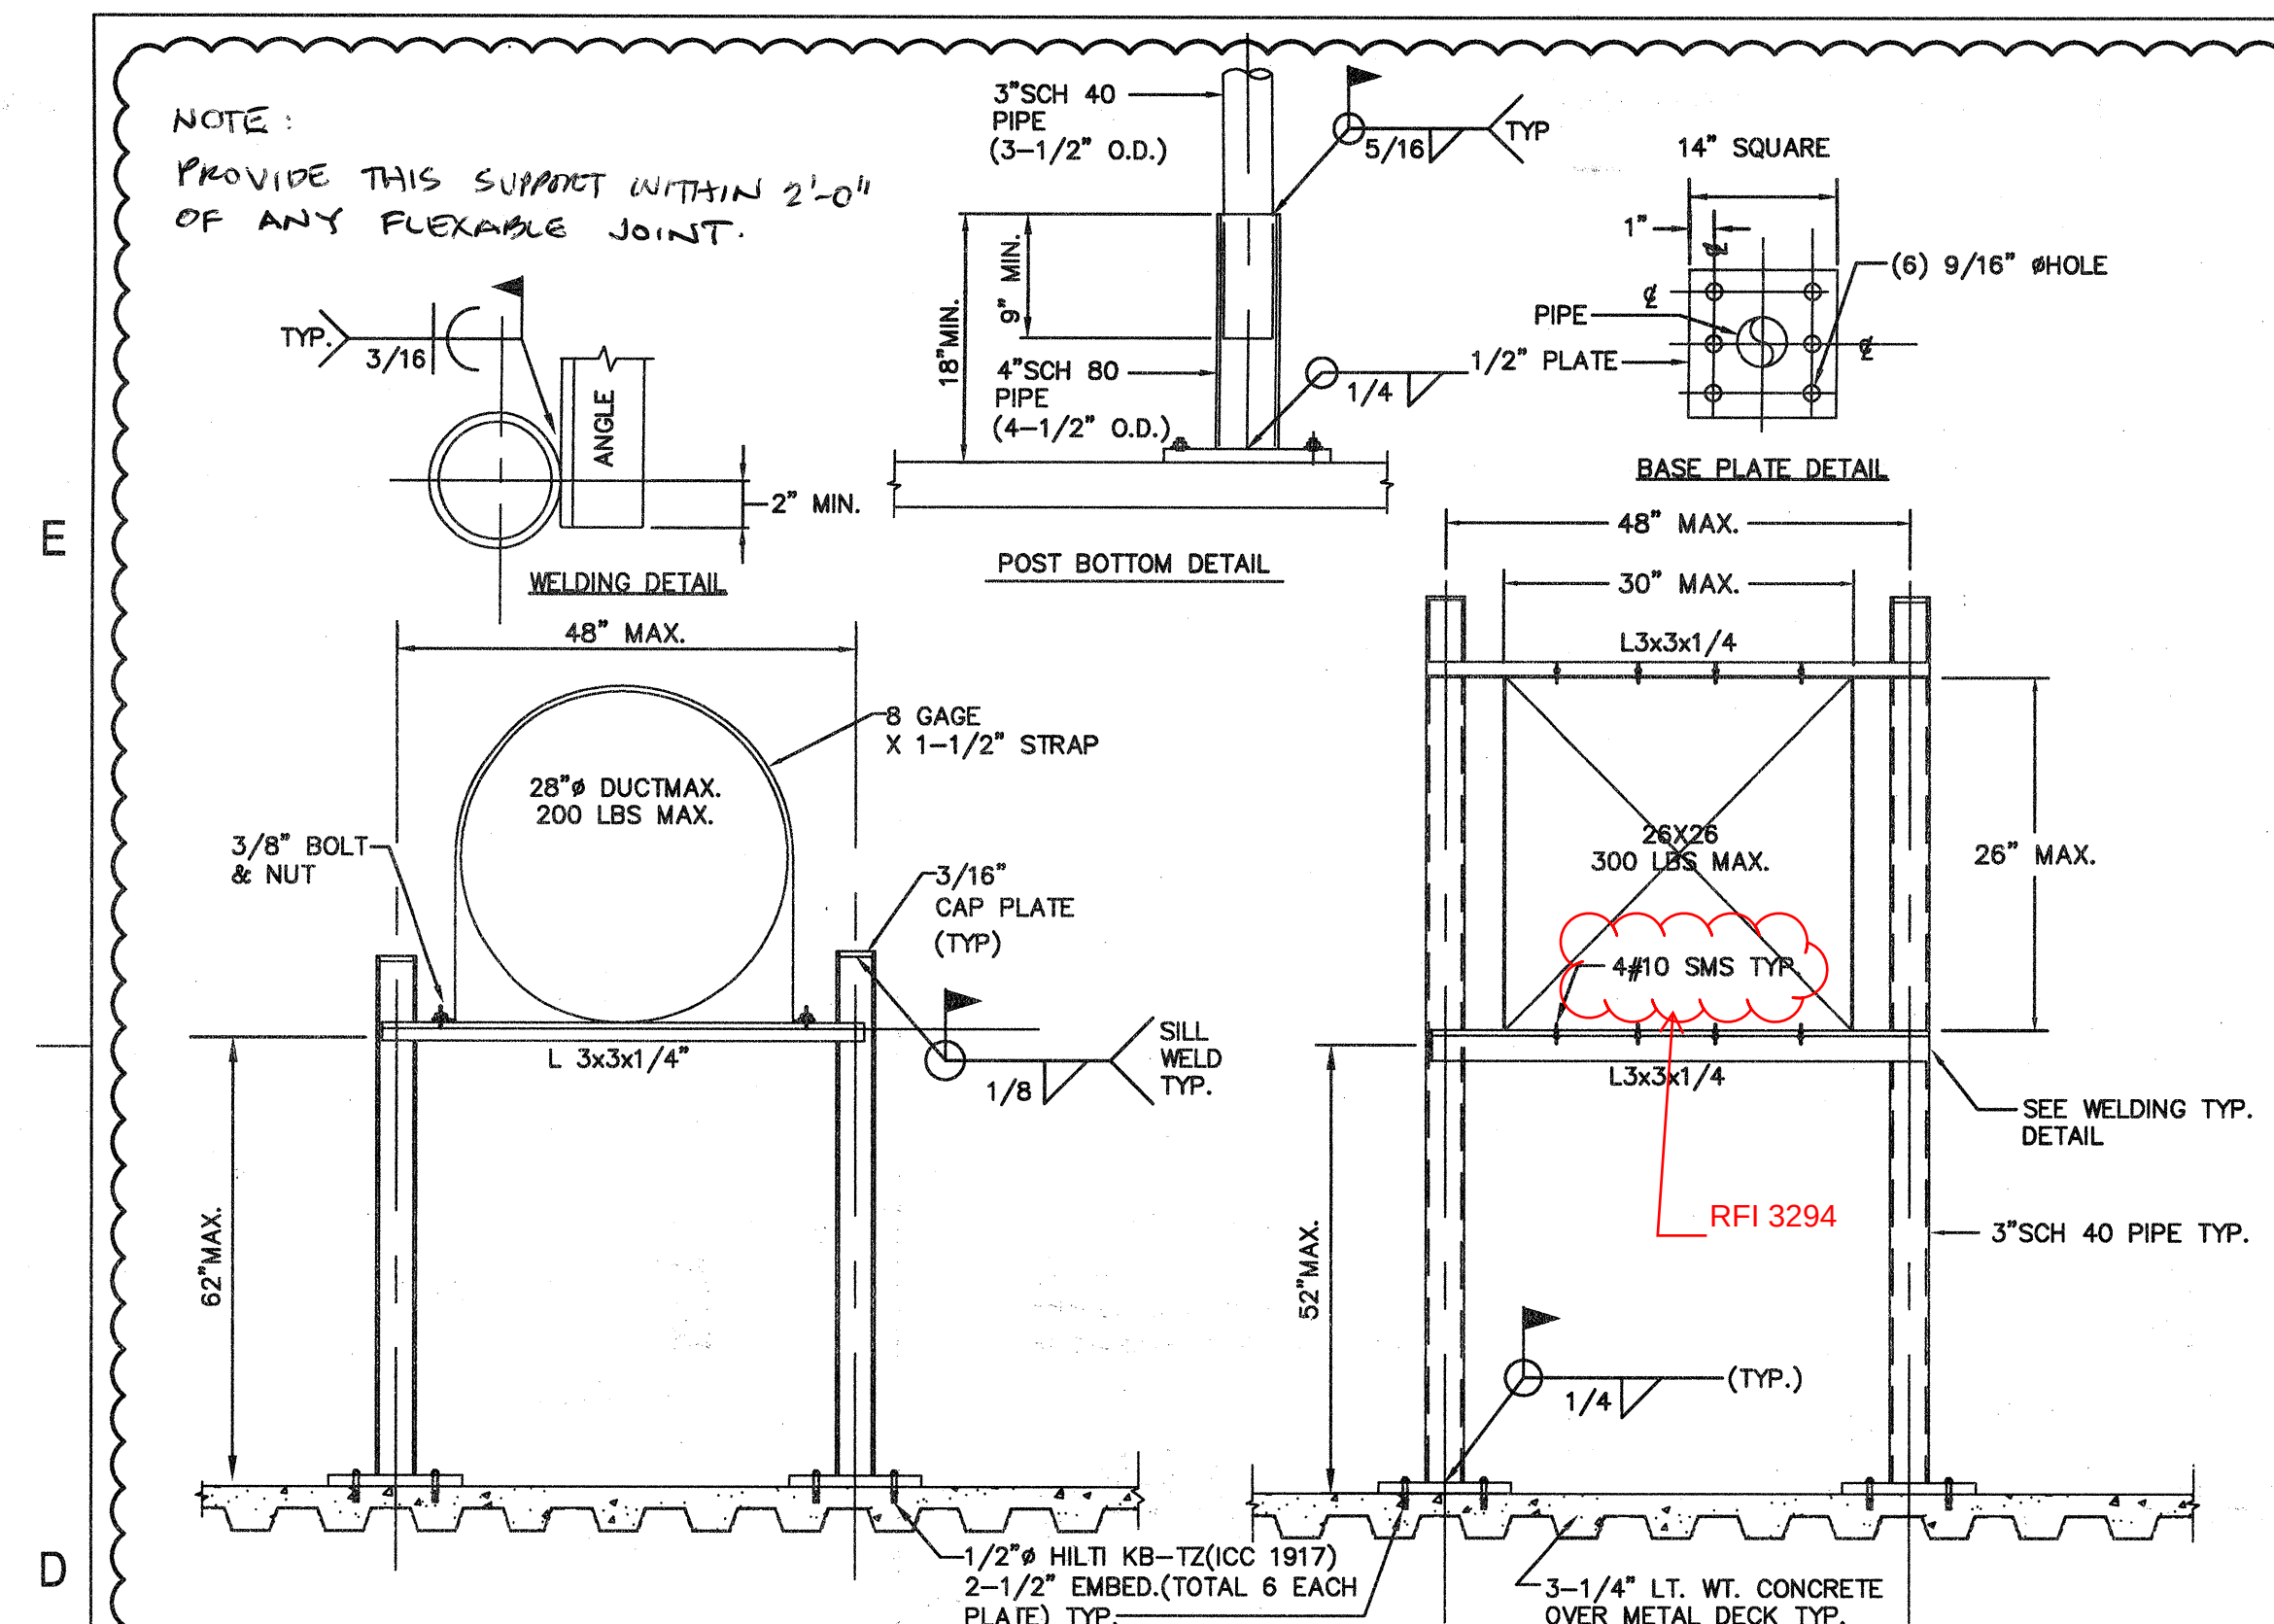

DUCT SUPPORT TYPE DS-7 (10' MAX SPACING) SCALE: NONE

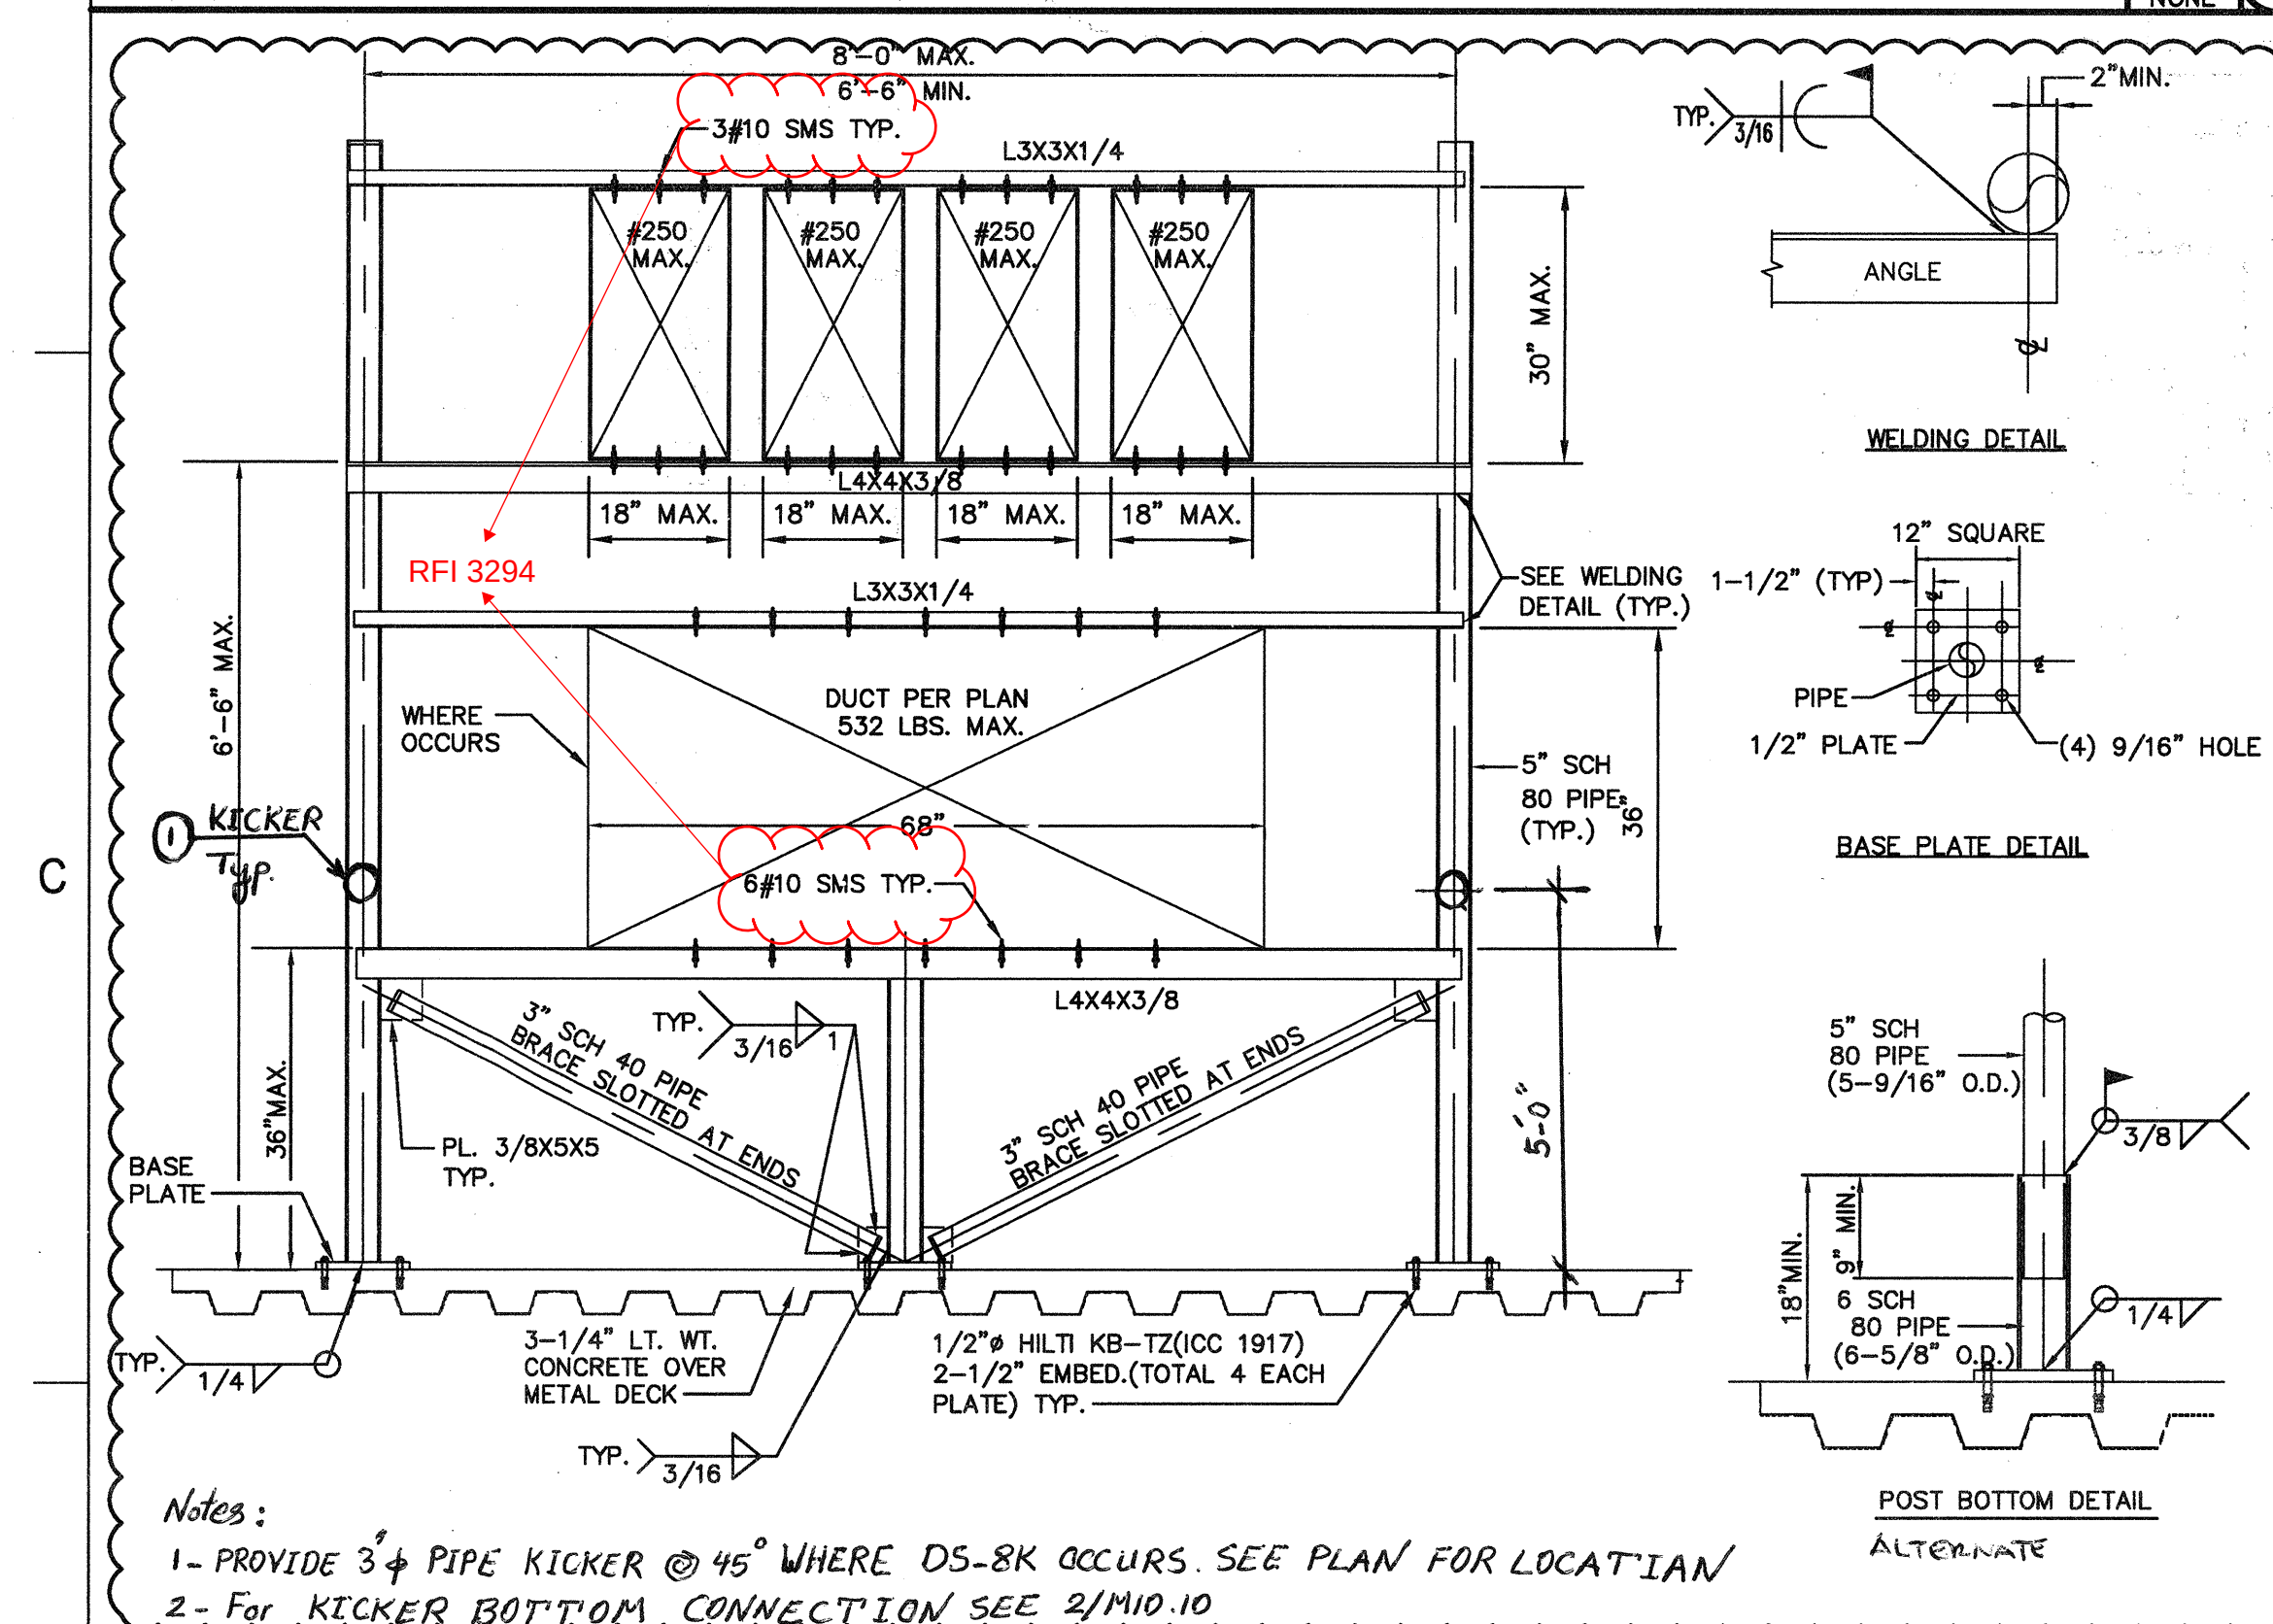

DUCT SUPPORT TYPE DS-4 AND DS-4K (10' MAX SPACING FOR ROOF) SCALE: NONE

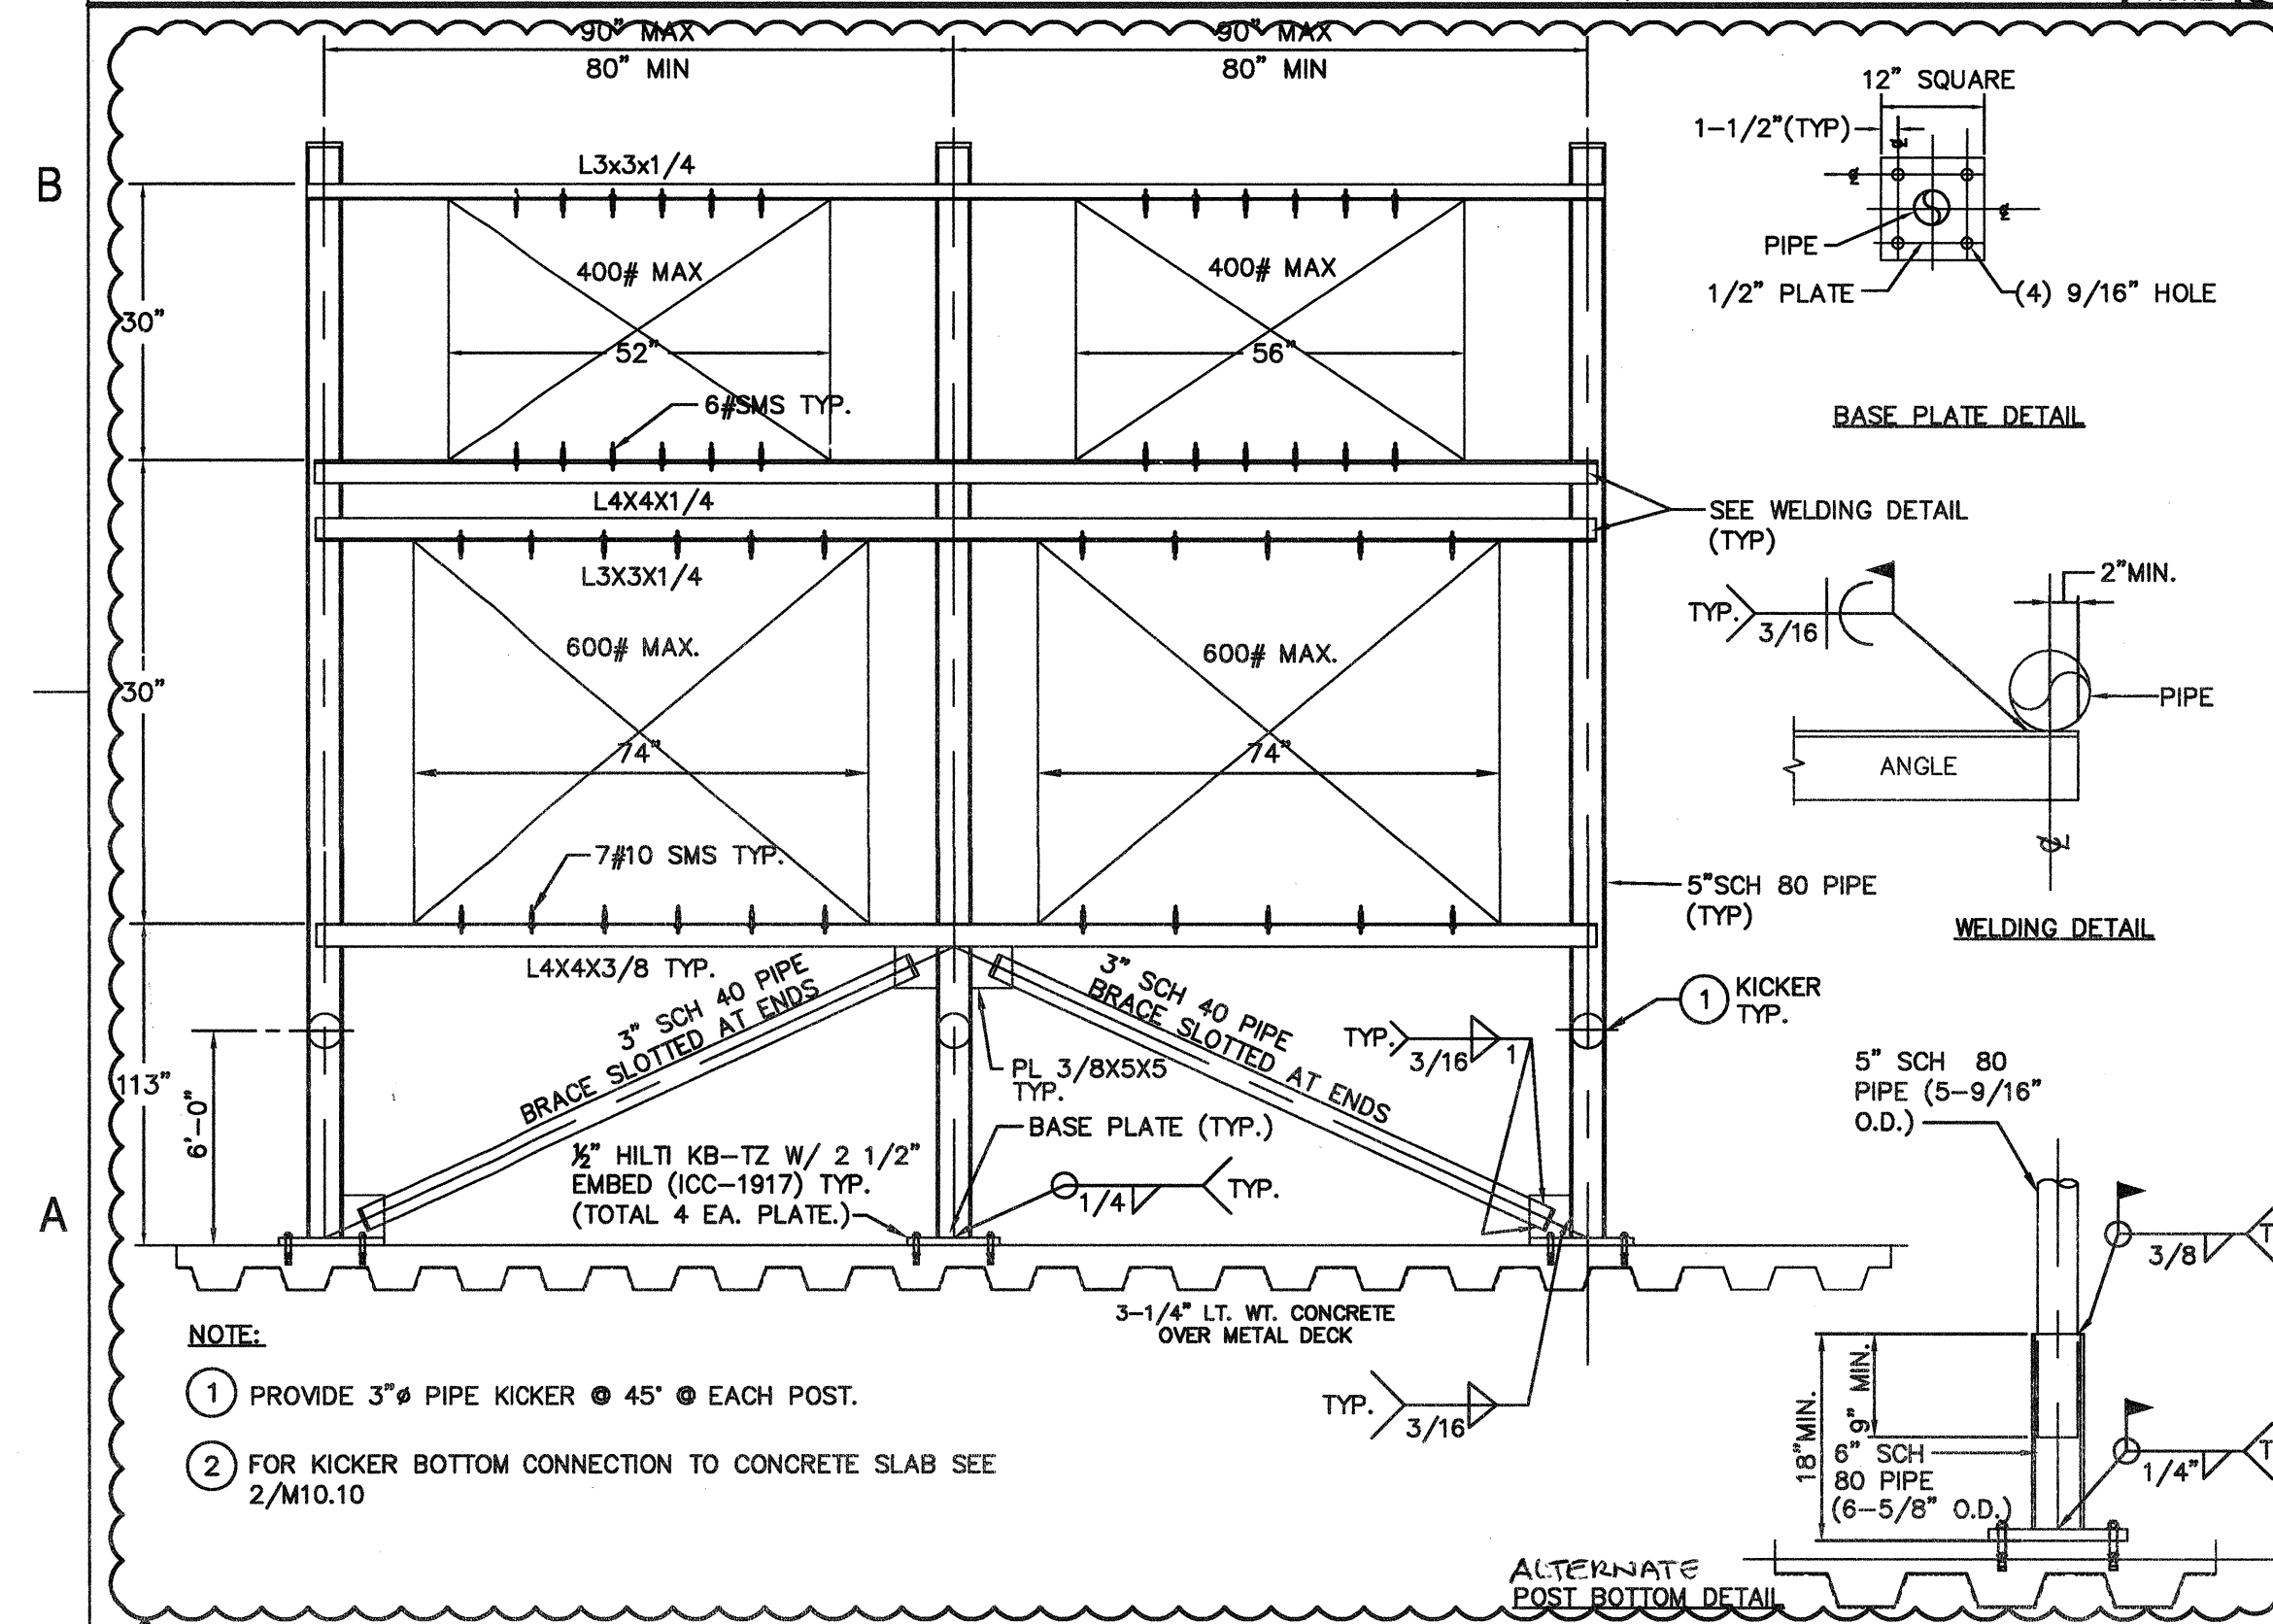

DUCT SUPPORT TYPE DS-1 (10' MAX SPACING FOR ROOF) SCALE: NONE

6 5 4 3 2 1

