© 2007 FKP Architects, Inc. All rights reserved. No part of this document may be reproduced or utilized in any form without prior written authorization of FKP Architects, Inc.

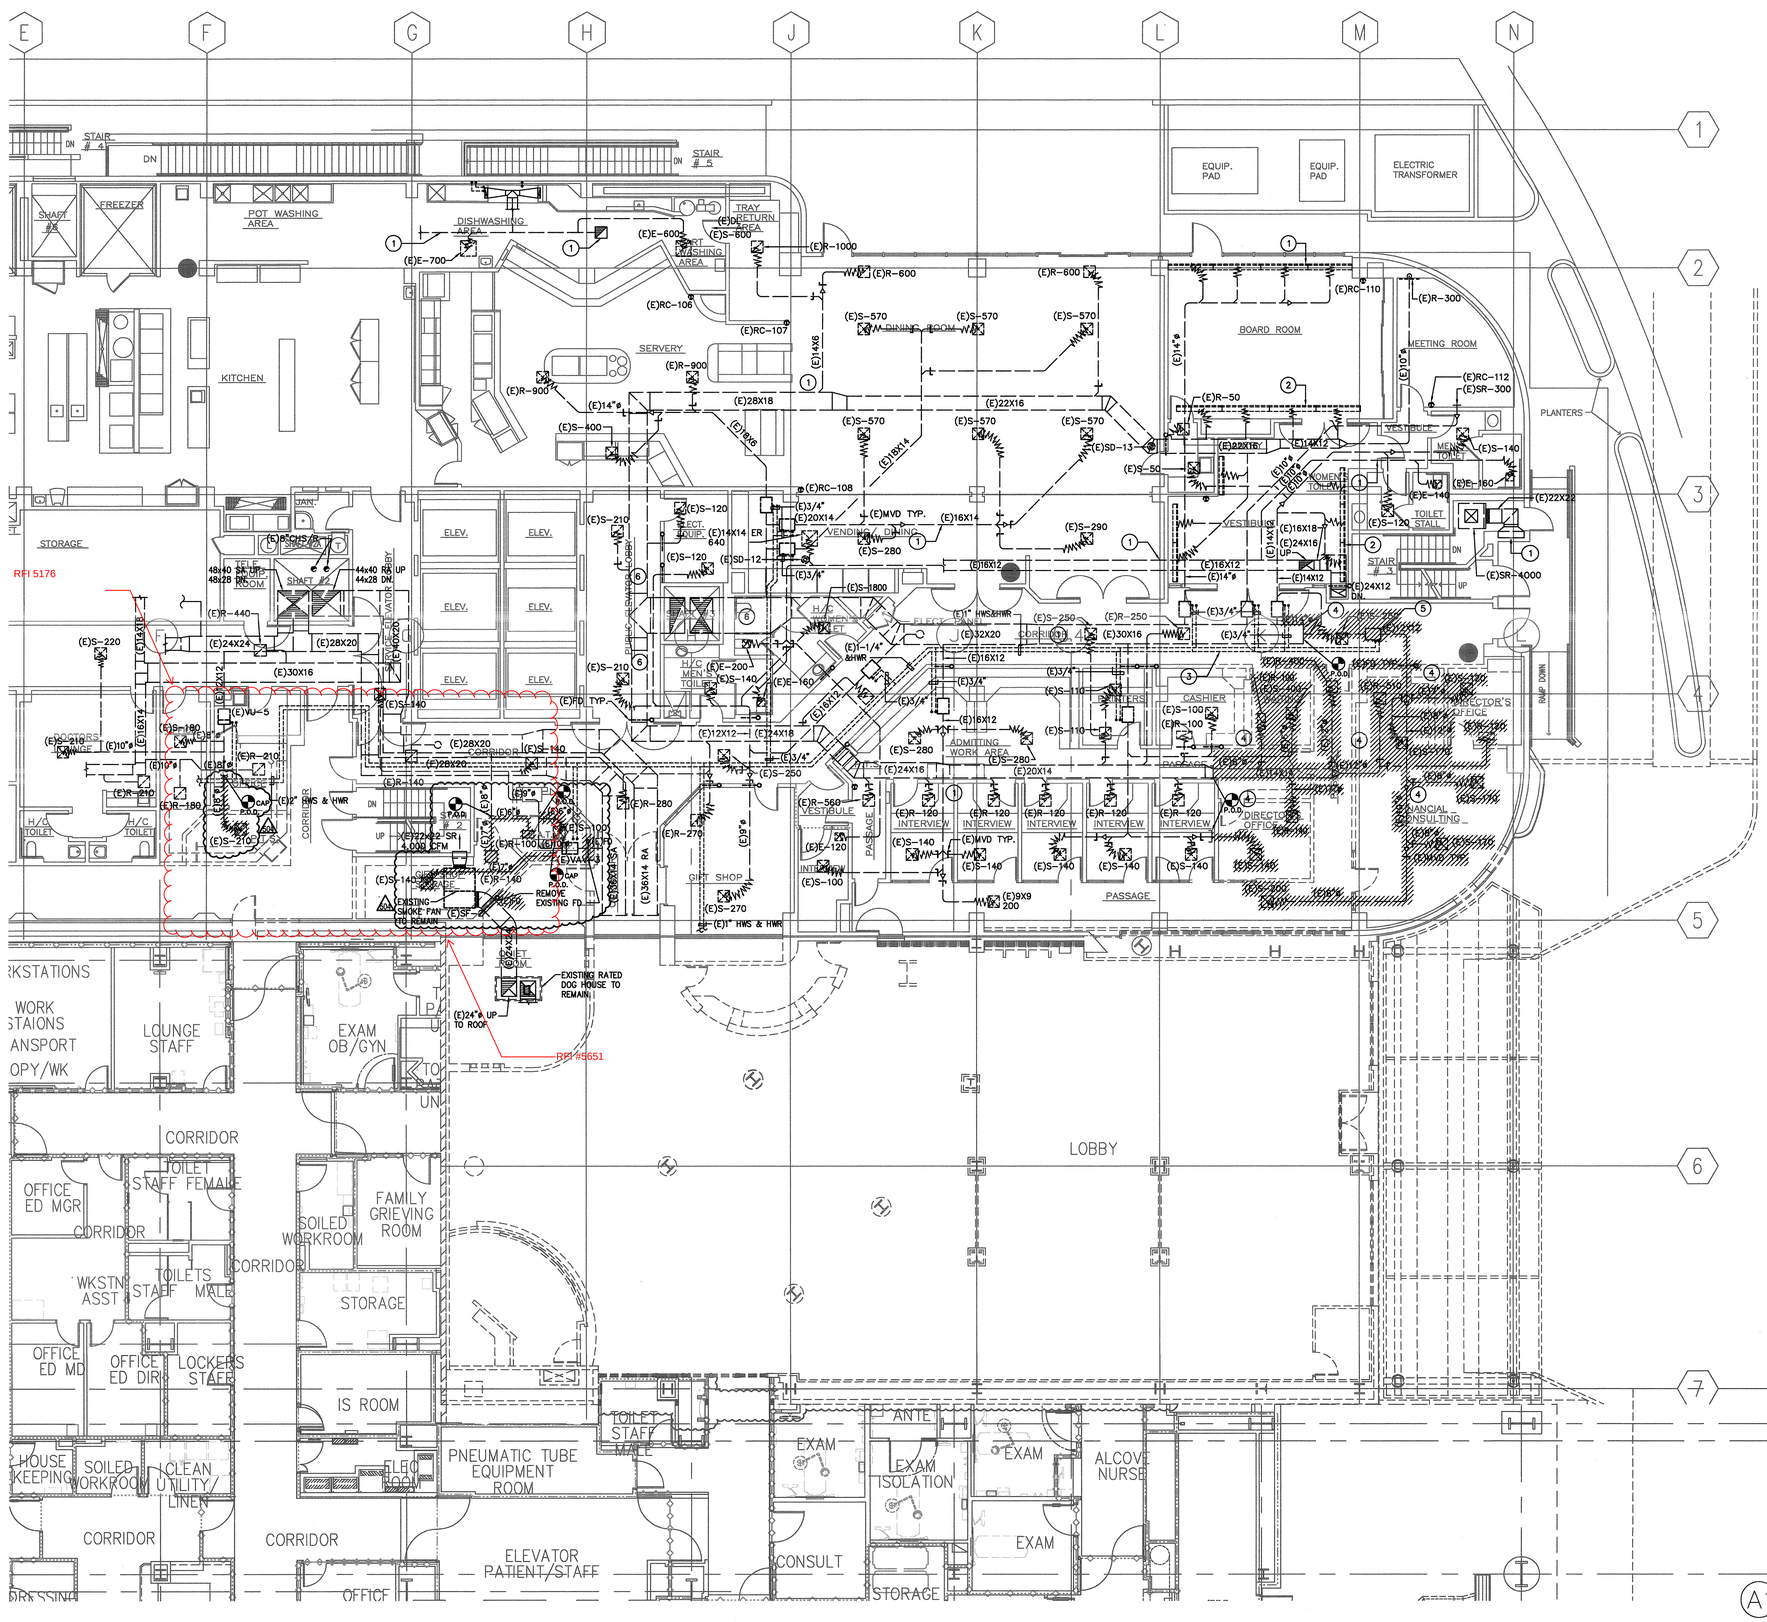

DEMOLITION NOTES:

1. EXISTING DUCTWORK, DIFFUSER/GRILLE TO REMAIN.
2. EXISTING 14'-0" LINEAR DIFFUSER TO REMAIN.
3. EXISTING HOT WATER SUPPLY & RETURN TO REMAIN.
4. REMOVE EXISTING DUCTWORK WITH DIFFUSER/GRILLE UP P.O.D. AND CAP REMAINING DUCTWORK.
5. REMOVE EXISTING VAV BOX WITH ASSOCIATED DUCTWORK AND PIPING.
6. PROVIDE AIR FLOW TRAVERSE READING BEFORE AND AFTER CONSTRUCTION. BALANCE AND MAINTAIN THE AIR FLOW TO MATCH THE EXISTING AIR FLOW CONDITION.

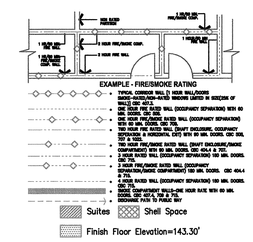

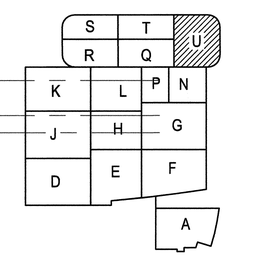

A1 Key Plan
N.T.S.

FKP Architects

ARCHITECT OF RECORD

"Architect of Record signature line only; this drawing was not prepared under the direct supervision of the Architect of Record. The direct responsibility for preparation of this sheet lies with its corresponding professional stamp and signature. The signature of the Architect of Record in general responsible charge of the project is provided as required by Title 24, Part 1, Section 7-115 (a)".

ARCHITECT - PAUL C. GLORIOD

CONSULTANT

TMAD TAYLOR & GAINES
- STRUCTURAL
- MECHANICAL
- ELECTRICAL
- CIVIL

100 South Anaheim Boulevard, Suite 150
Anaheim, California 92805
Phone: 714.490.5555 Fax: 714.490.5560
Project No. 2305-163-07

REGISTERED PROFESSIONAL ENGINEER GERARD MCCLOSKEY No. 22257 Exp. 12/31/11 MECHANICAL STATE OF CALIFORNIA

Changes on these drawings do not consist of materially altered changes to approved drawings and don't require a change order.
OSHPD review AOO
OSHPD review FLSO
OSHPD review DSE

REVISIONS

3	04/24/2012	CHANGE ORDER #360

APPROVAL

Office of Statewide Health Planning & Development
REVIEWED FOR ACCESSIBILITY WITH THE REQUIREMENTS OF T24, CCR & DSA-PR/AP

CHANGE ORDERS 360
INSTRUCTION BULLETINS
DEFERRED APPROVALS
ADDENDUM

PAD 2012-04131

PROJECT NAME

CHILDREN'S HOSPITAL OF ORANGE COUNTY
455 S. Main St.
Orange, CA 92868-3874

TOWER II

CHOC HOSPITAL

PROJECT NUMBER

12011.00
Increment #7

OSHPD - PROJECT NUMBER

IL 072072-30

ISSUE

OSHPD PERMIT

DATE

01/27/2010

SCALE

1/8"=1'-0"

DRAWING TITLE

LEVEL 1 MECHANICAL DEMOLITION PLAN AREA - U

DRAWING NUMBER

M2.1U

T:\2004D\2305\2305-163-07\MC-7_M-P\M2_1U.DWG
4/23/2012
RSMOM