

FKP Architects

ARCHITECT OF RECORD

Achitect of Record signature line only; this drawing was not prepared under the direct supervision of the Architect of Record. The direct responsibility for preparation of this sheet lies with its corresponding professional stamp and signature. The signature of the Architect of Record in general responsible change of the project is provided as required by Title 24, Part 1, Section 7-115 (a)(7).

ARCHITECT - PAUL C. GLORIO

CONSULTANT

T M A D
TAYLOR & GAINES
• STRUCTURAL
• MECHANICAL
• ELECTRICAL
• CIVIL

100 South Anaheim Boulevard, Suite 150
Anaheim, California 92805
Phone: 714.490.5555 Fax: 714.490.5560
Project No. 2305-163-07




Changes on these drawings do not consist of material alterations or changes to approved drawings and don't require a change order.
OSHPD review ACO
OSHPD review FLSO
OSHPD review DSE

REVISIONS

04/15/2011 CHANGE ORDER #135

APPROVAL

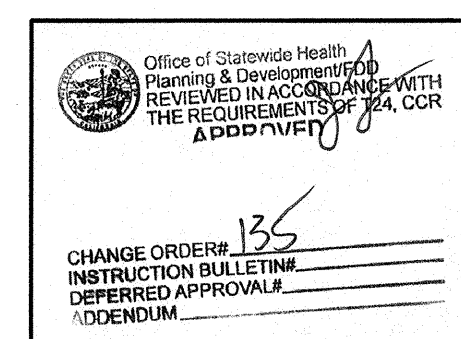

PROJECT NAME

CHILDREN'S HOSPITAL
OF ORANGE COUNTY

455 S. Main St.
Orange, CA 92668-3874

RECEIVED
TOWER II SEPT. 21 2011
Mc CARTHY



PROJECT NUMBER

12011.00
Increment #7

OSHPD - PROJECT NUMBER

IL 072072-30

ISSUE

OSHPD PERMIT

DATE

01/27/2010

SCALE

DRAWING TITLE

LEVEL 2 - MECHANICAL
DEMOLITION PLAN
AREA - P


DRAWING NUMBER

M2.2P


DESIGN KEY NOTES

- EXISTING NOT IN CONTRACT
- EXISTING TO REMAIN
- DEMOLISH

LEGEND

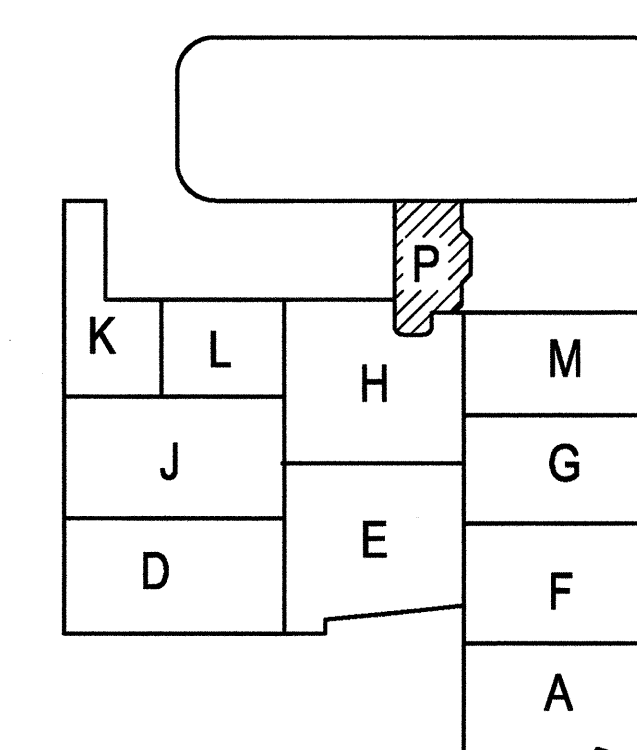


KEY PLAN

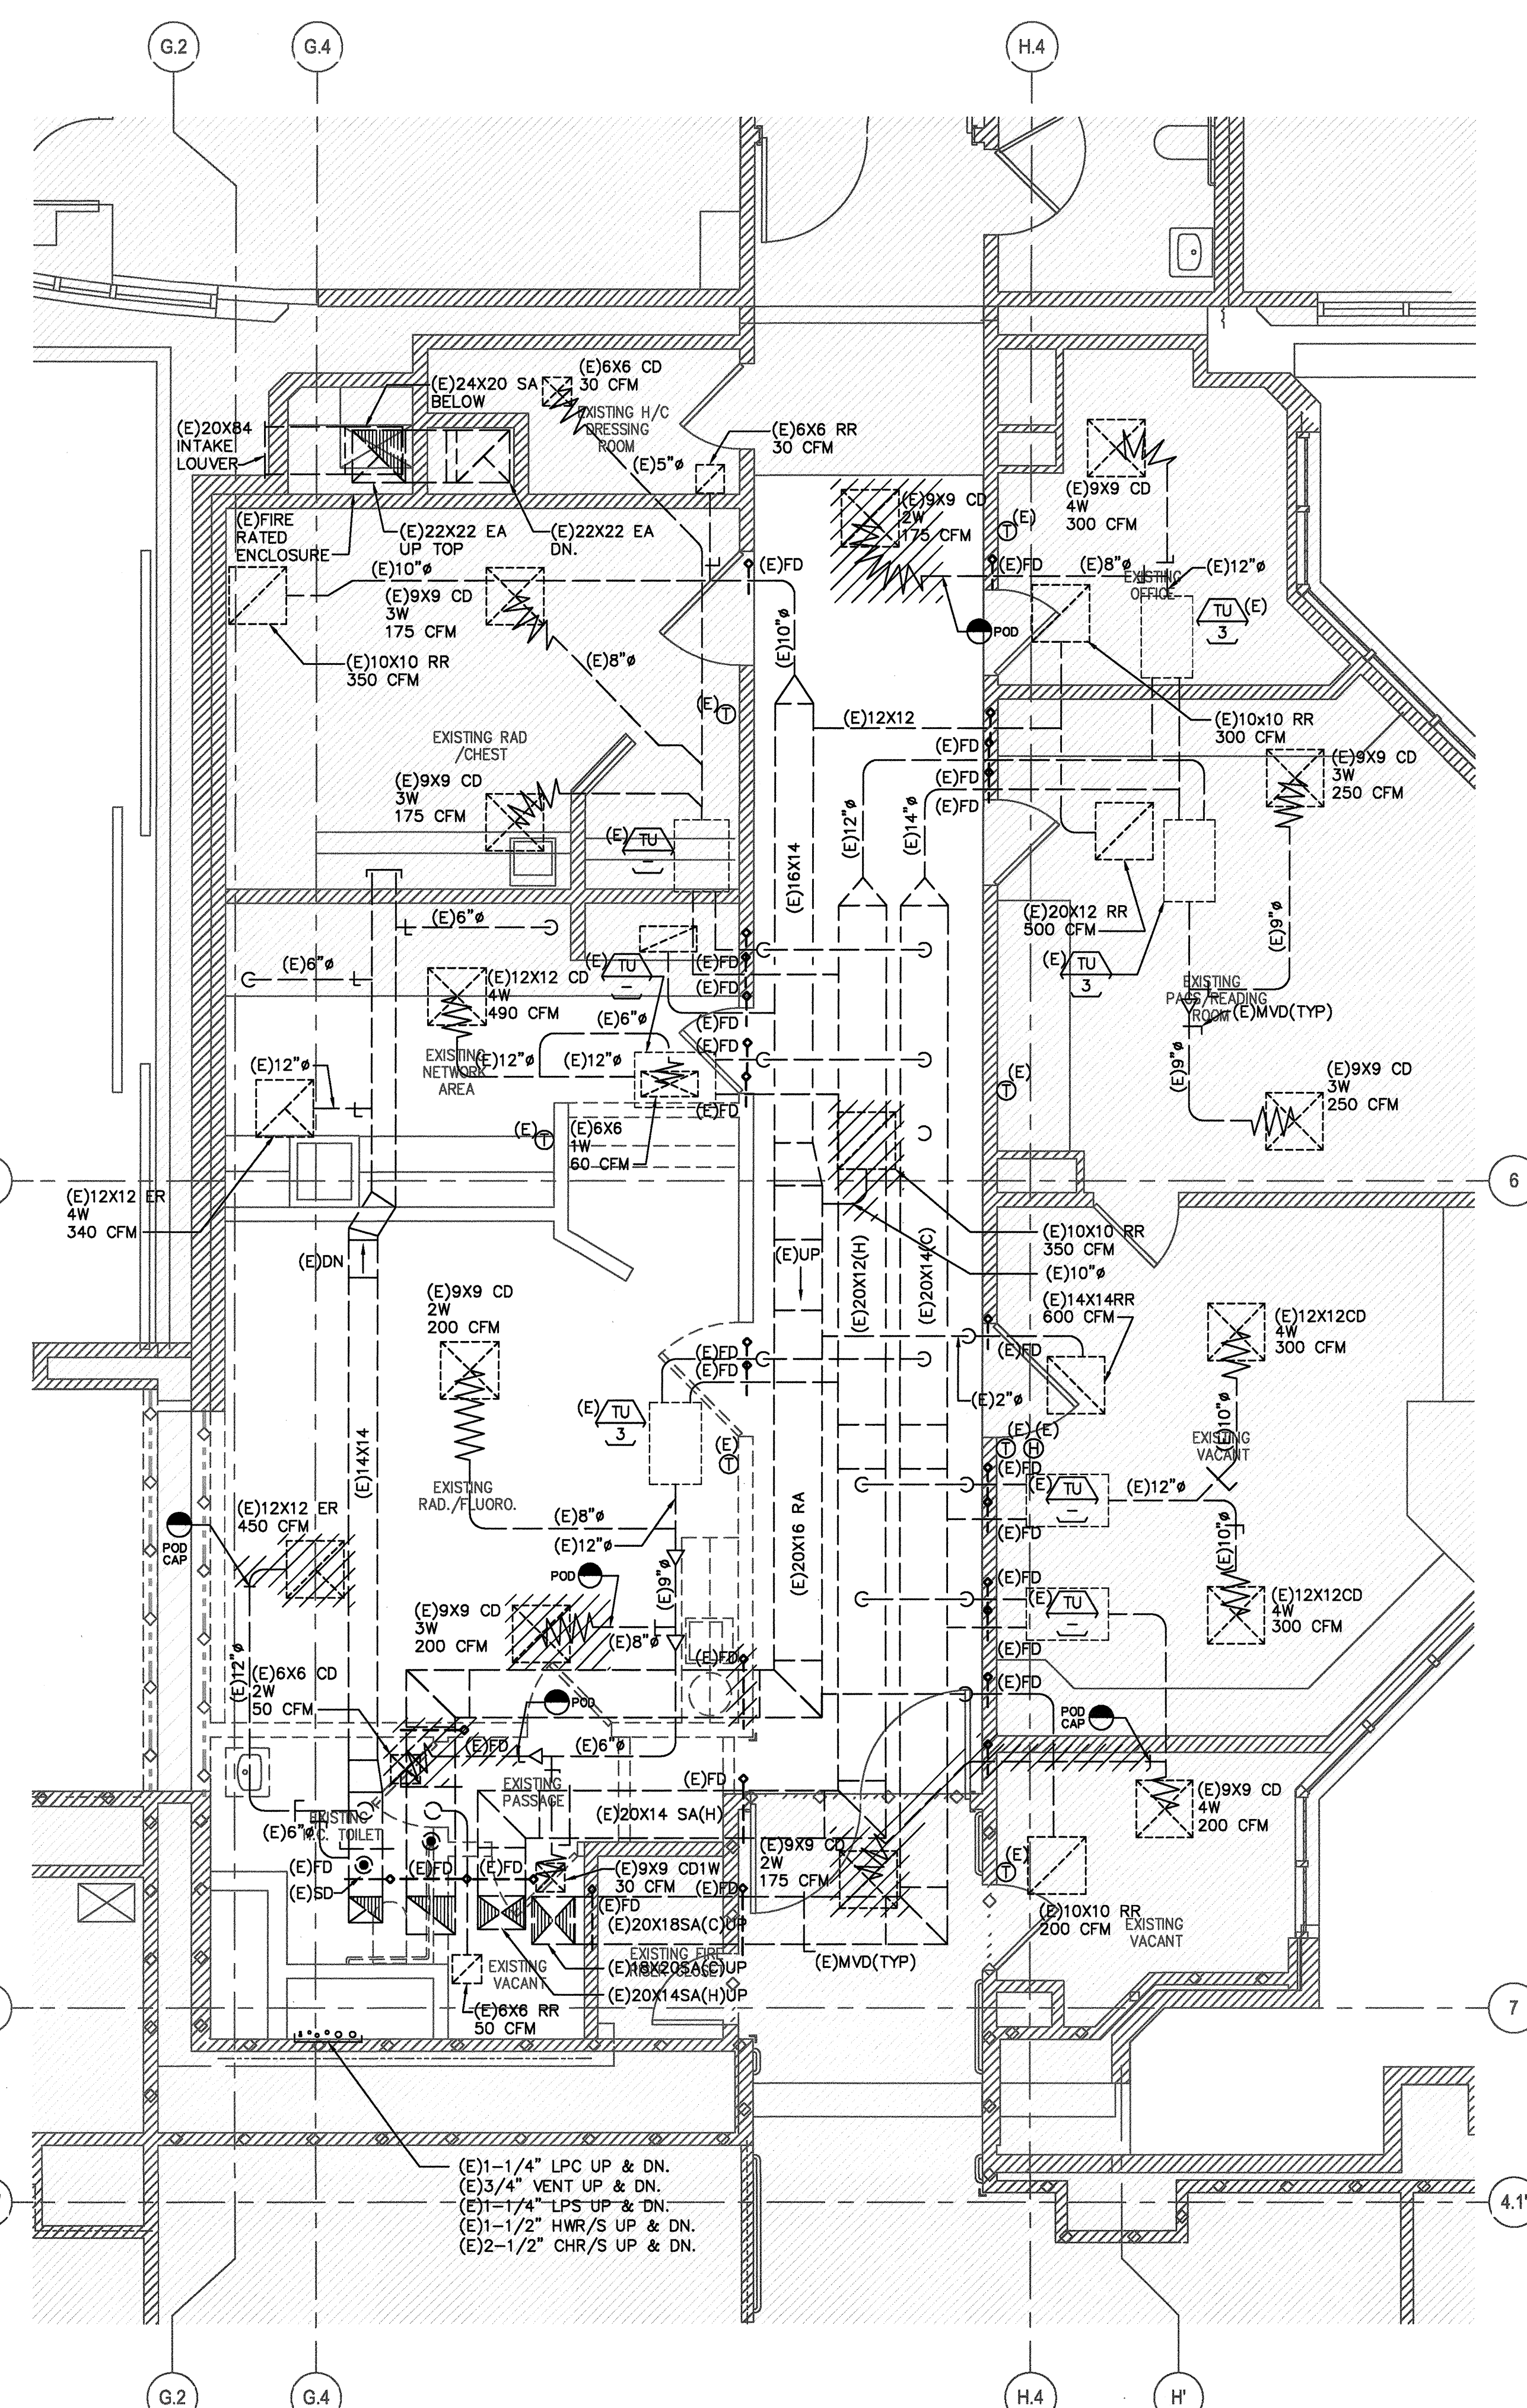

DEMOLITION - LEVEL 2 - PHASE II

SCALE 1/4"=1'-0"

2

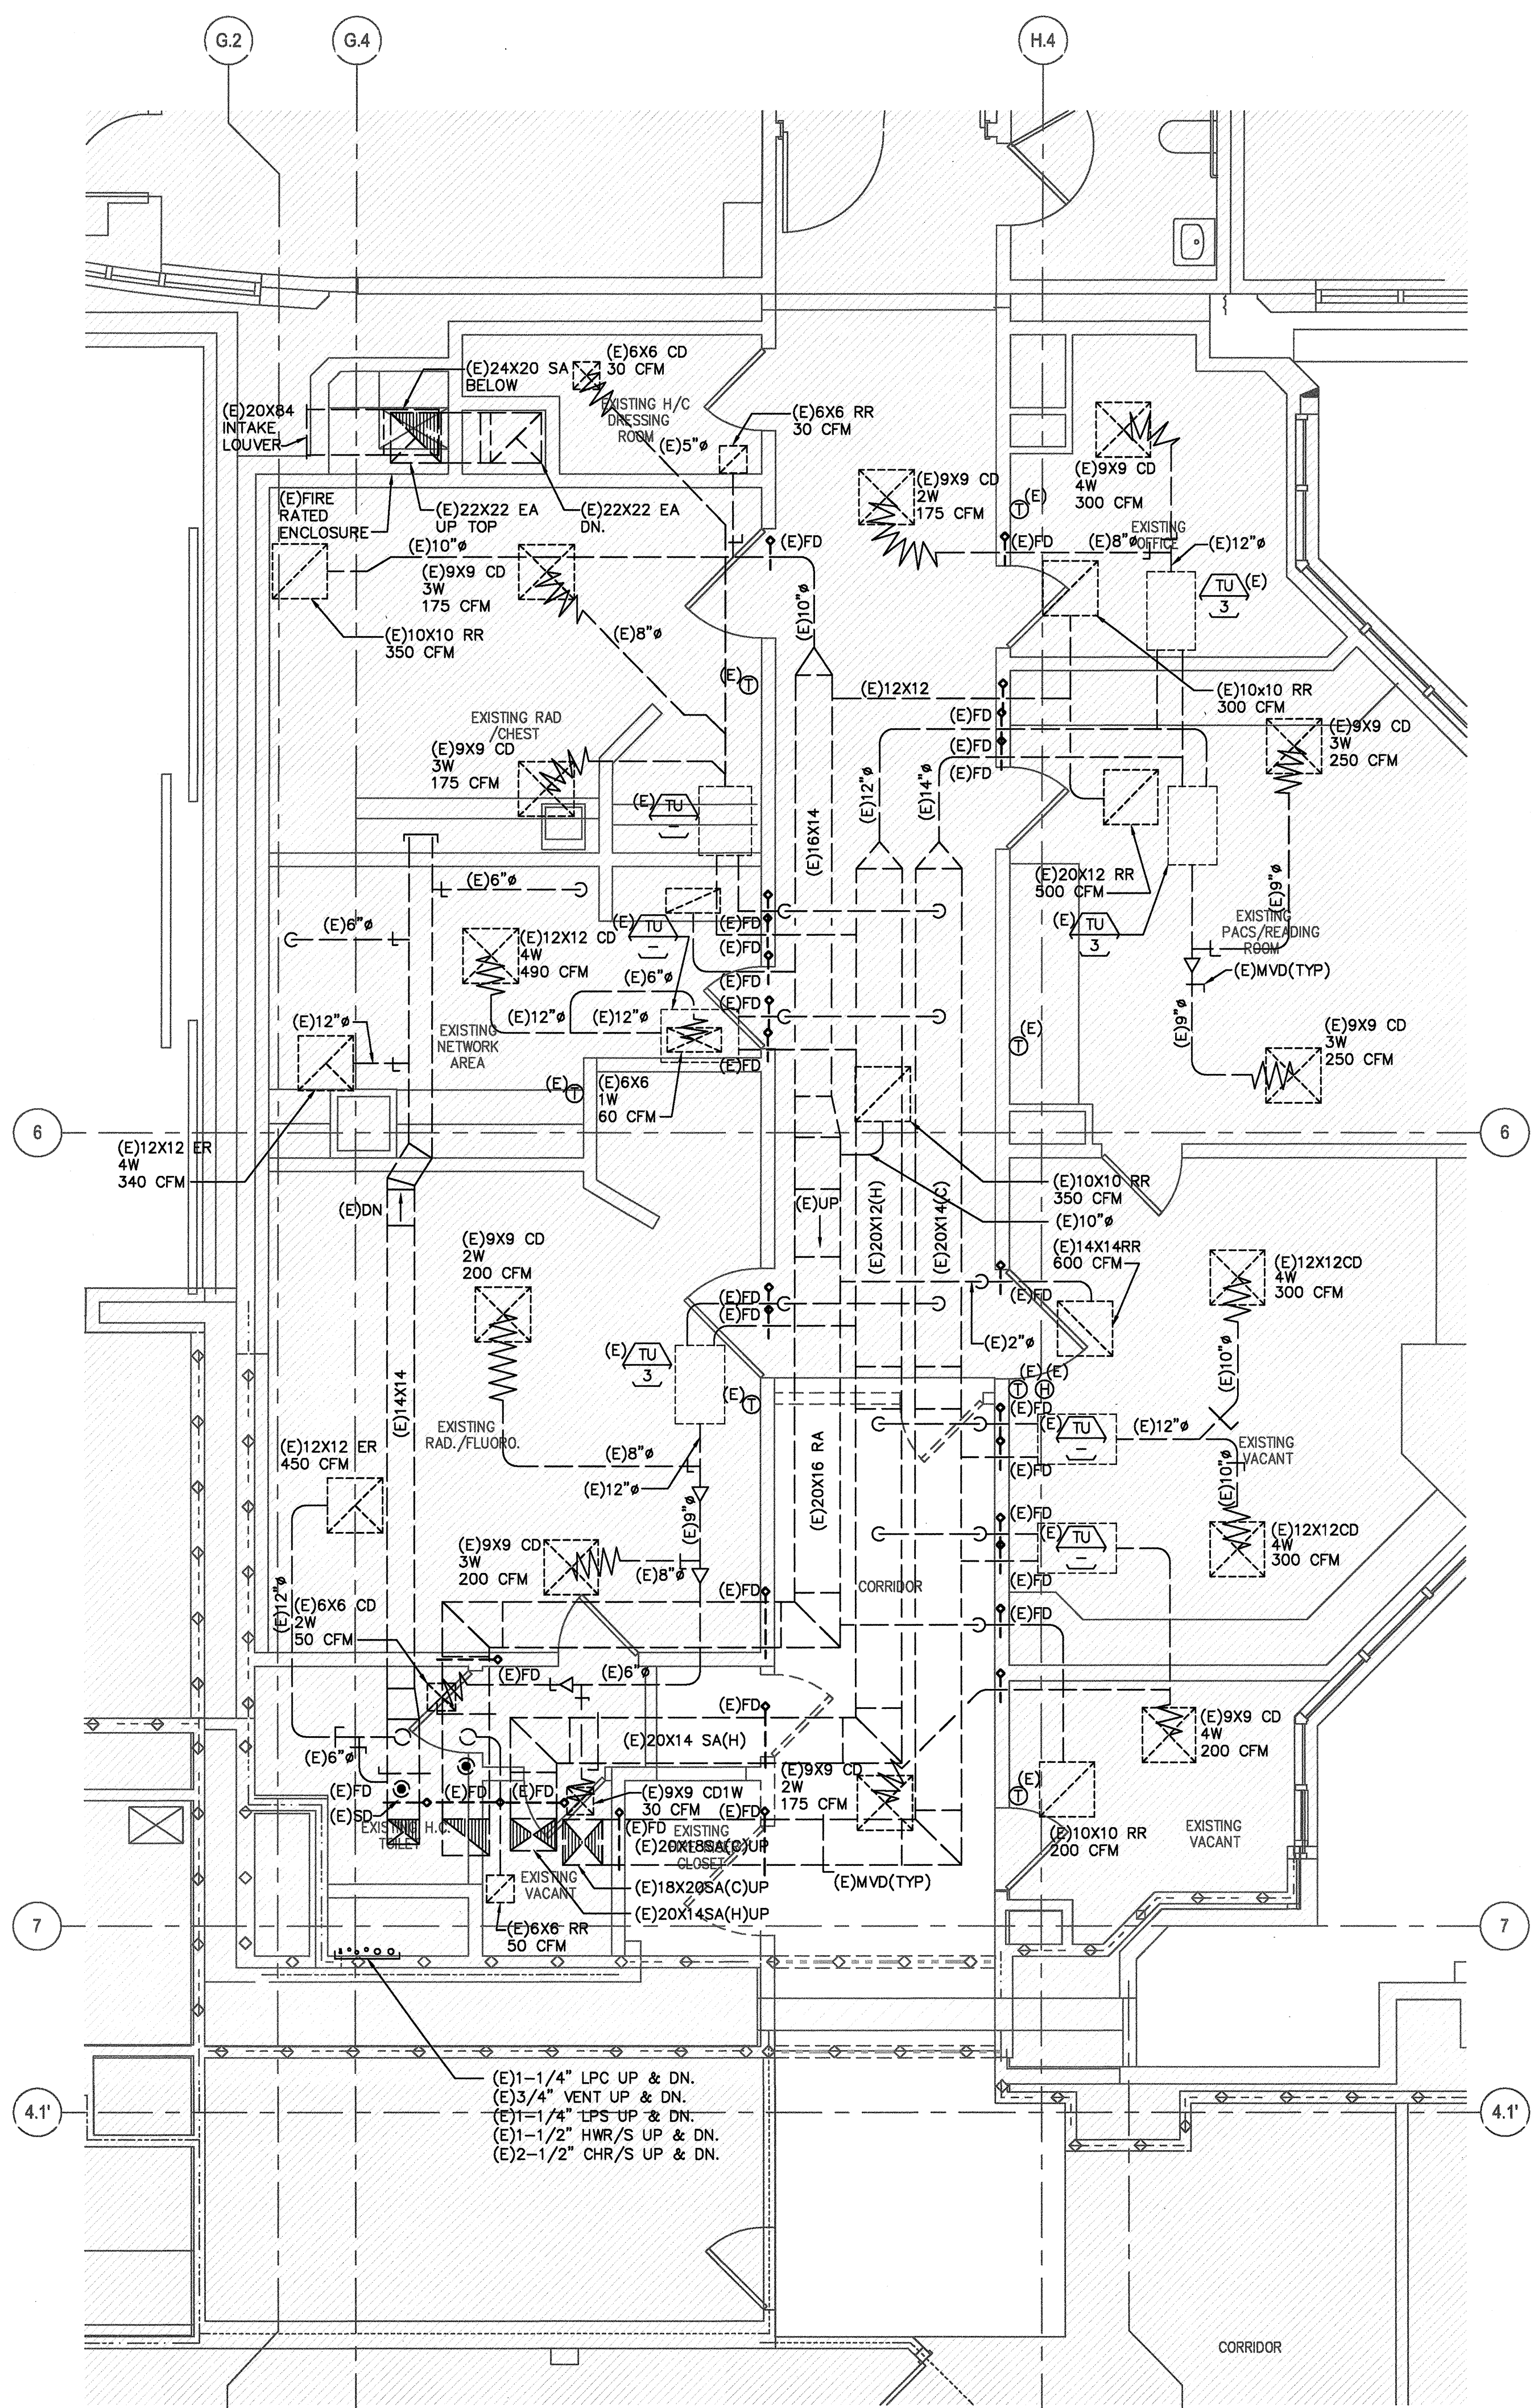

DEMOLITION - LEVEL 2 - PHASE I

SCALE 1/4"=1'-0"

5

6