



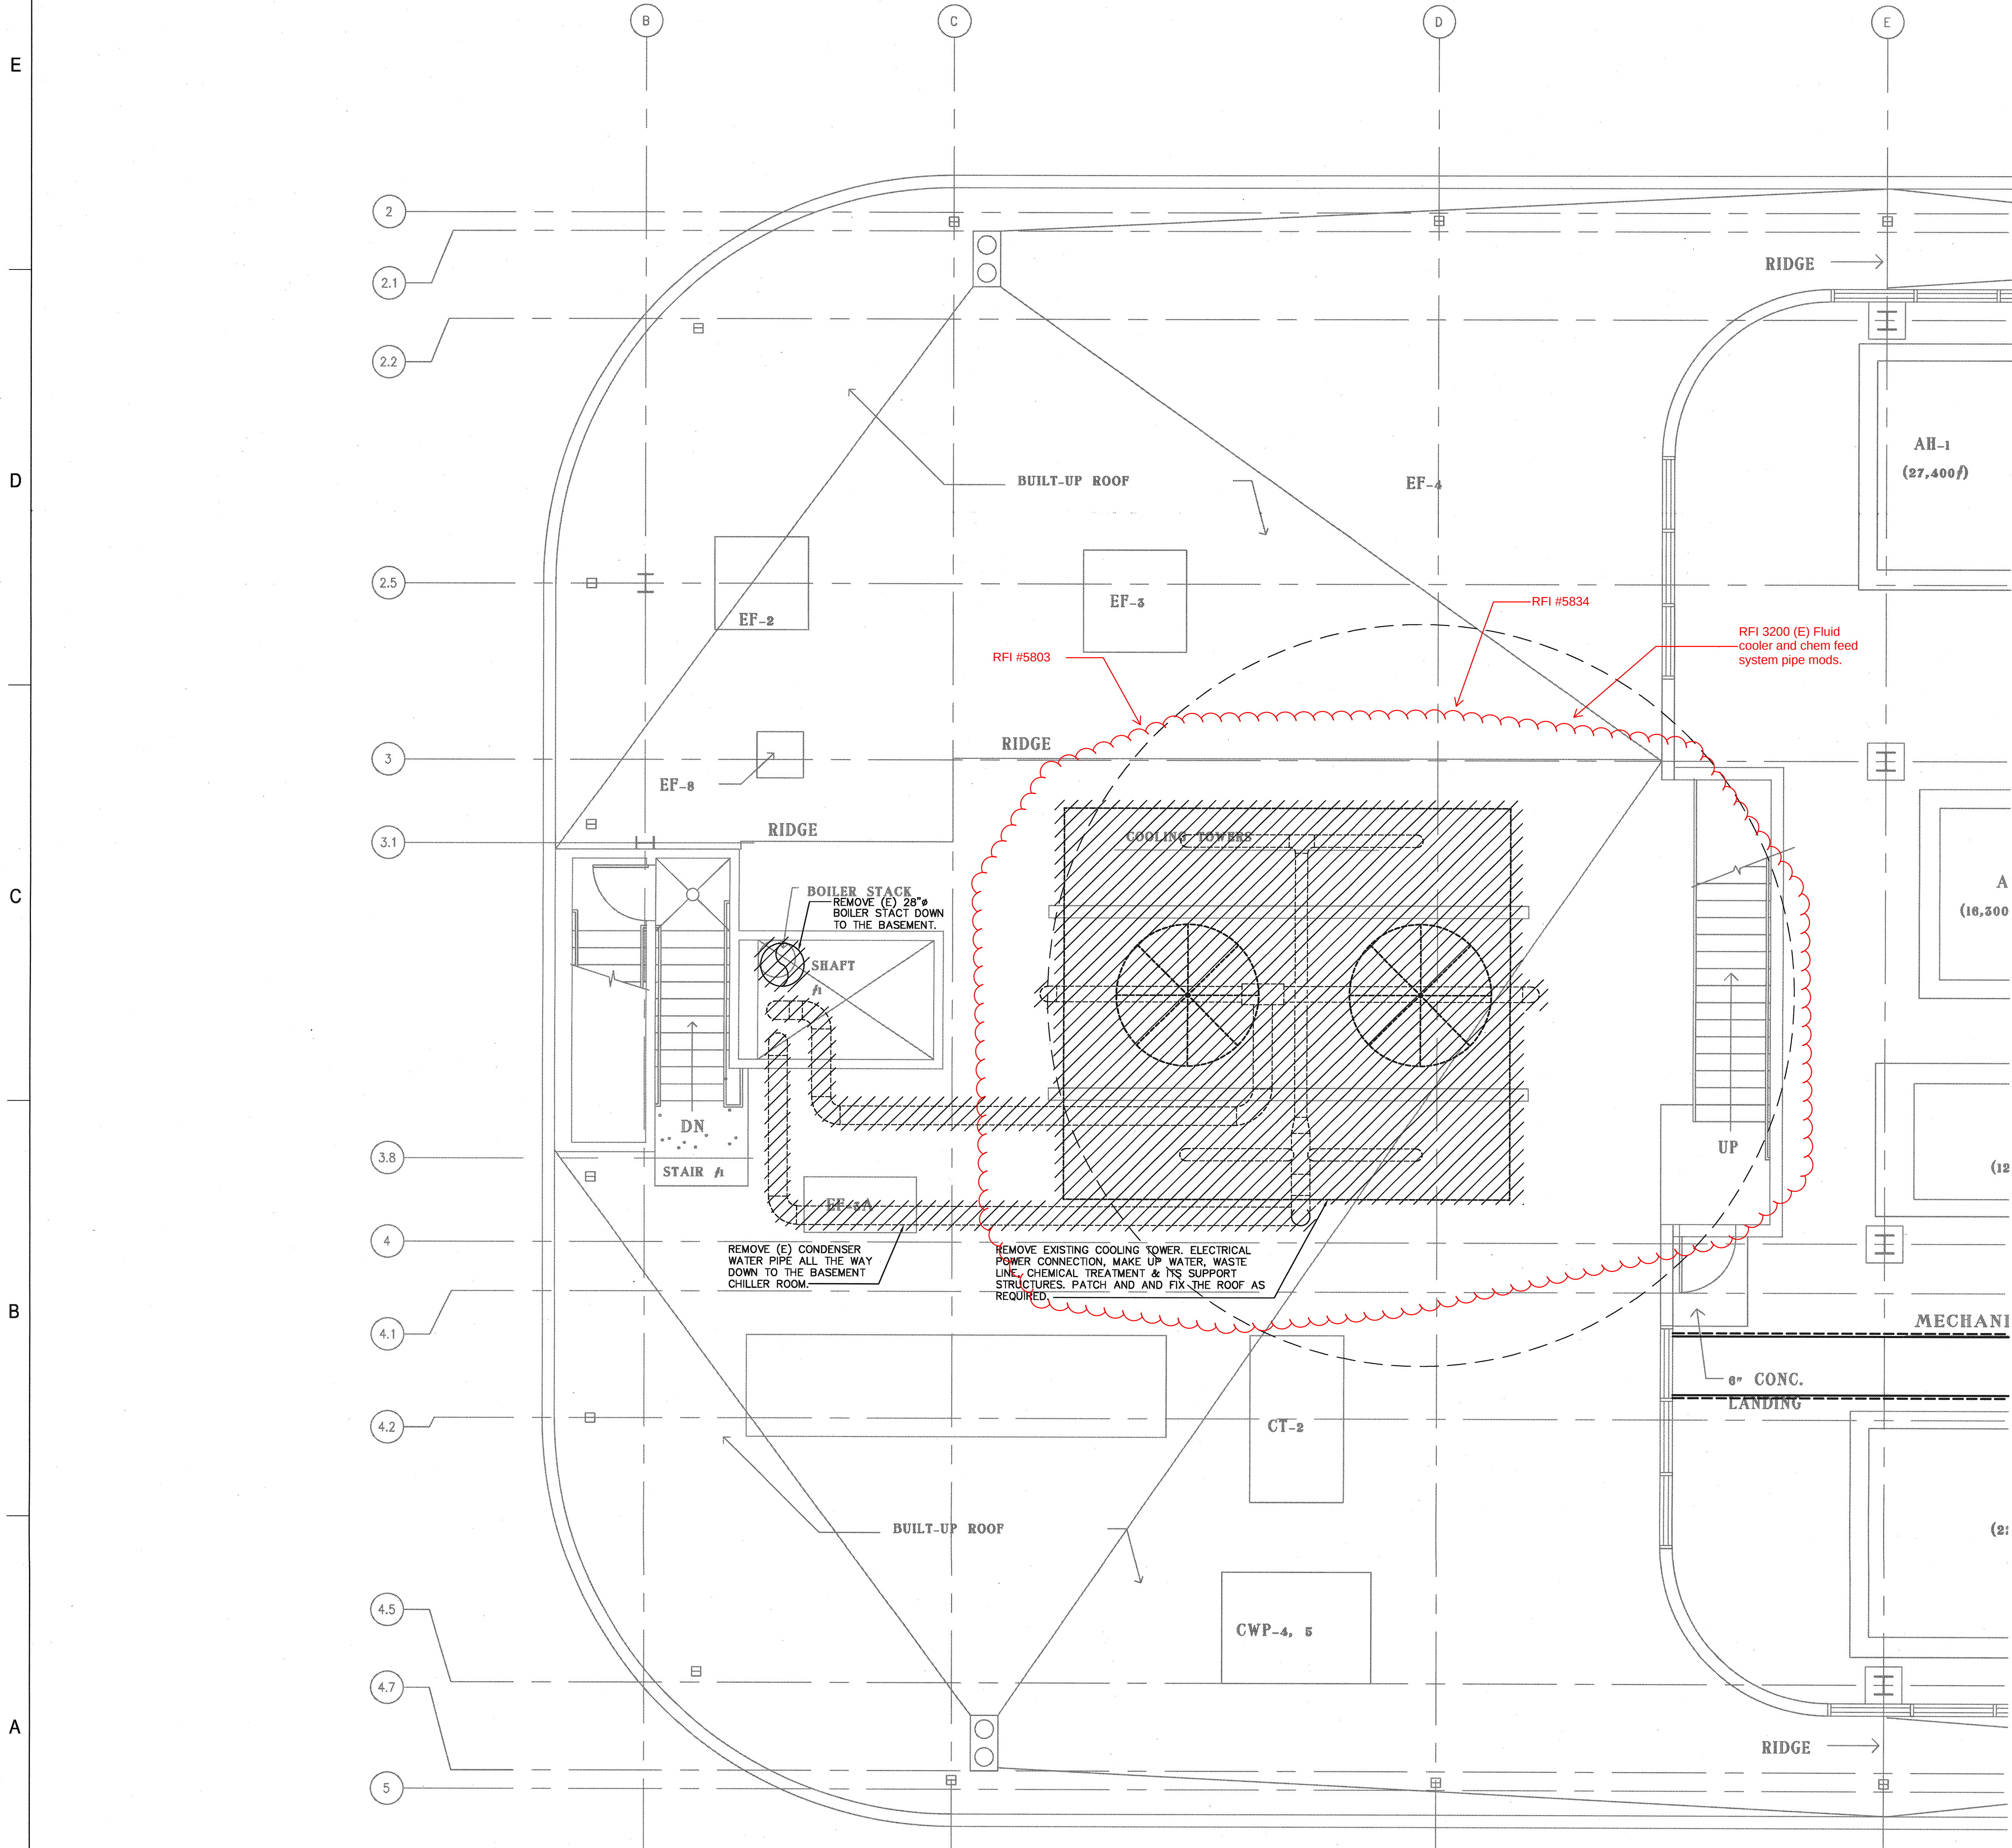


LEVEL 8 DEMOLITION PLAN - AREAS R & S

DESIGN KEY NOTES

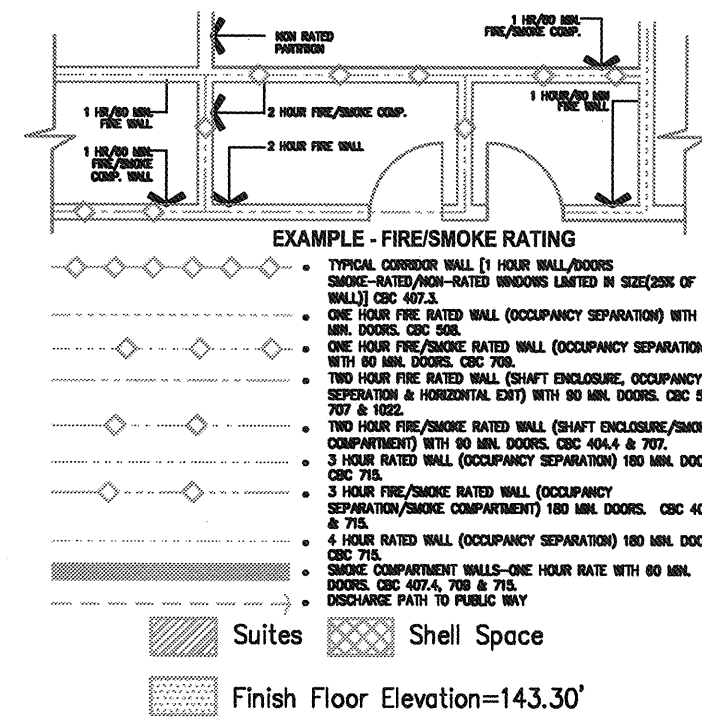

SEE M6 SERIES FOR PROJECT
BOILER & CHILLER ROOMS
PHASING PLAN.

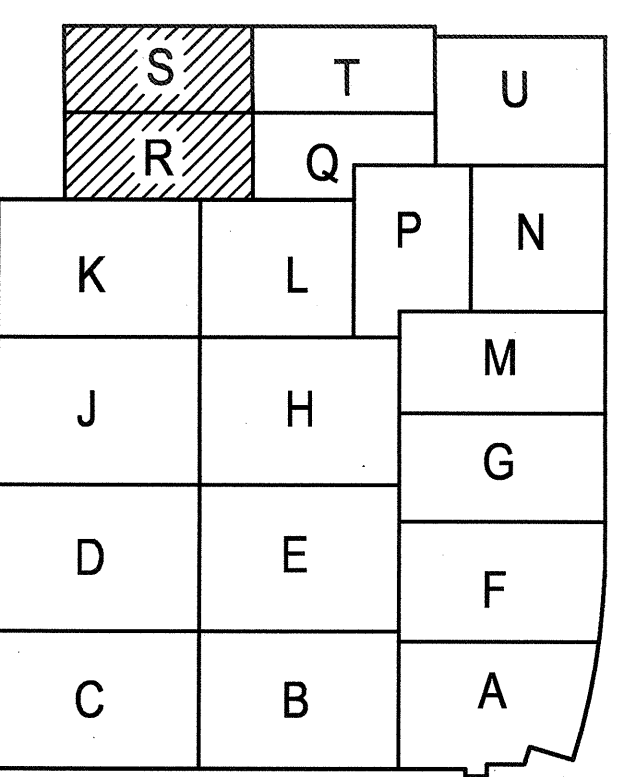

(A1) Key Plan
N.T.S.

KEY PLAN



ARCHITECT OF RECORD

*Architect of Record signature line only; this drawing was not prepared under the direct supervision of the Architect of Record. The direct responsibility for preparation of this sheet lies with its corresponding professional stamp and signature. The signature of the Architect of Record in general responsible for the project is provided as required by Title 24, Part 2, Section 7-115(a).

ARCHITECT - PAUL C. GLORIOT

CONSULTANT

T M A D
TAYLOR & GAINES
• STRUCTURAL
• MECHANICAL
• ELECTRICAL
• CIVIL
100 South Anaheim Boulevard, Suite 150
Anaheim, California 92805
Phone: 714.490.5555 Fax: 714.490.5560
Project No. 2305-163-07



REVISIONS

APPROVAL



JAN 28 2010

Office of Statewide Health
Planning & Development
FACILITIES DEVELOPMENT DIVISION

PROJECT NAME

**CHILDREN'S HOSPITAL
OF ORANGE COUNTY**

455 S. Main St.
Orange, CA 92668-3874

TOWER II



PROJECT NUMBER

**12011.00
Increment #7**

OSHPD - PROJECT NUMBER
IL 072072-30

ISSUE

OSHPD PERMIT

DATE

01/27/2010

SCALE

1/4"=1'-0"

DRAWING TITLE

**LEVEL 8 DEMOLITION
PLAN AREAS - R & S**

DRAWING NUMBER

M2.8