© 2007 FKP Architects, Inc. All rights reserved. No part of this document may be reproduced or utilized in any form without prior written authorization of FKP Architects, Inc.

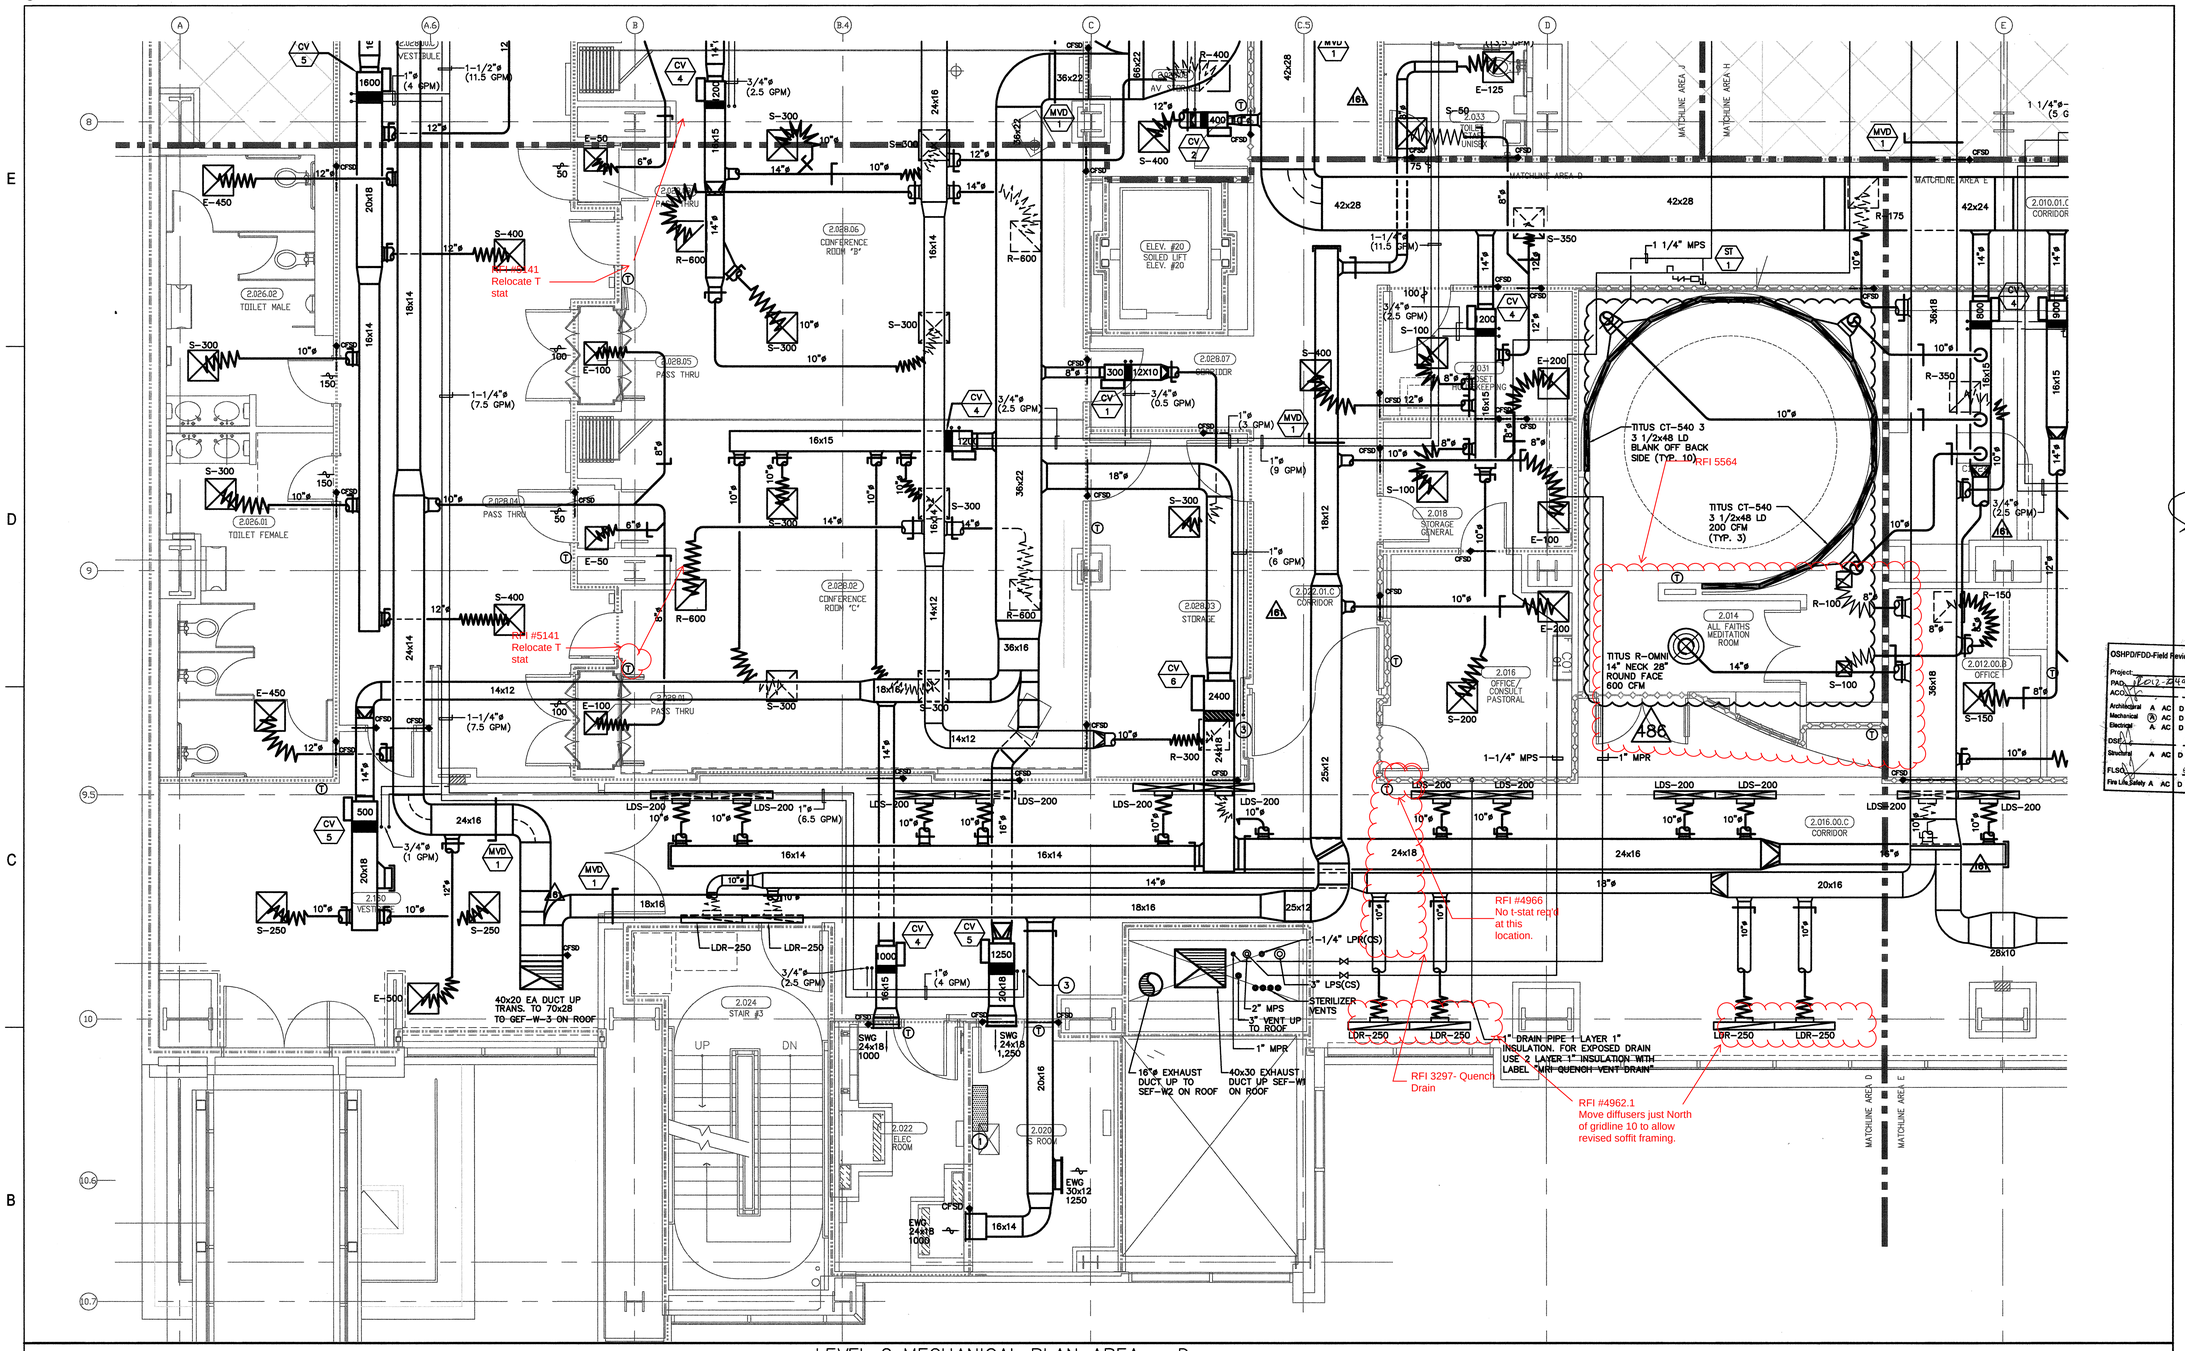

LEVEL 2 MECHANICAL PLAN AREA – D

DESIGN KEY NOTES

1. DDC CONTROL PANEL (PER CONTRACT & PROJECT REQUIREMENTS)
2. ALL WELDED SS CONSTRUCTION WITH 2 HR. FIRE RATED DUCT SHAFT.
3. PROVIDE 3-WAY VALVE FOR REHEAT COIL.
4. STERILIZER LOCATED ON THE THIRD FLOOR. STEAM LINE SUPPLY AND CONDENSATE RETURN SERVING THE STERILIZERS FROM LEVEL 2.
5. COOLING ONLY CV BOX (16)

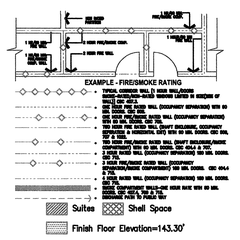

DESIGN KEY NOTES

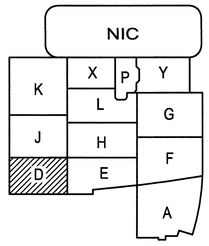

A1 Key Plan
N.T.S.

KEY PLAN

T:\22CAD\2305\2305-163-07\NIC-7_M-P\M3_2D.DWG
4/24/2012
BTRAN

FKP Architects

ARCHITECT OF RECORD

"Achitect of Record signature line only; this drawing was not prepared under the direct supervision of the Architect of Record. The direct responsibility for preparation of this sheet lies with its corresponding professional stamp and signature. The signature of the Architect of Record in general responsible charge of the project is provided as required by Title 24, Part 1, Section 7-115 (a)"

ARCHITECT - PAUL C. GLORIOD

CONSULTANT

TMAD TAYLOR &GAINES
- STRUCTURAL
- MECHANICAL
- ELECTRICAL
- CIVIL

100 South Anaheim Boulevard, Suite 150
Anaheim, California 92805
Phone: 714.490.5555 Fax: 714.490.5560
Project No. 2305-163-07

REGISTERED PROFESSIONAL ENGINEER
DENNIS M. TAYLOR
No. 22257
Exp. 12/31/11
MECHANICAL
STATE OF CALIFORNIA

REVISIONS

1	03/01/2011	CHANGE ORDER #134
2	04/30/2012	CHANGE ORDER #350

OSHPD/FDD-Field Review Tracking
Project
PAD 12012-24481
ACO 5/21/12
Architectural A AC D (X) Refer
Mechanical (X) AC D X Refer
Electrical A AC D (X) Refer
DSA 5/21/12
Structural A AC D (X) Refer
FLSO 5/21/12
Fire Life Safety A AC D (X) Refer

APPROVAL

Office of Statewide Health Planning & Development/FDD
REVIEWED IN ACCORDANCE WITH THE REQUIREMENTS OF T24, CCR
APPROVED
MAY 21 2012

CHANGE ORDER# 350
INSTRUCTION BULLETIN#
REFERRED APPROVAL#
PROJECT NAME

CHILDREN'S HOSPITAL OF ORANGE COUNTY
455 S. Main St.
Orange, CA 92868-3874

TOWER II

CHOC HOSPITAL

PROJECT NUMBER
12011.00
Increment #7

OSHPD - PROJECT NUMBER
IL 072072-30

ISSUE
OSHPD PERMIT

DATE
01/27/2010

SCALE
1/4" = 1' - 0"

DRAWING TITLE
LEVEL 2 MECHANICAL PLAN AREA - D

DRAWING NUMBER
M3.2D