Site utilization - Addendum Answer

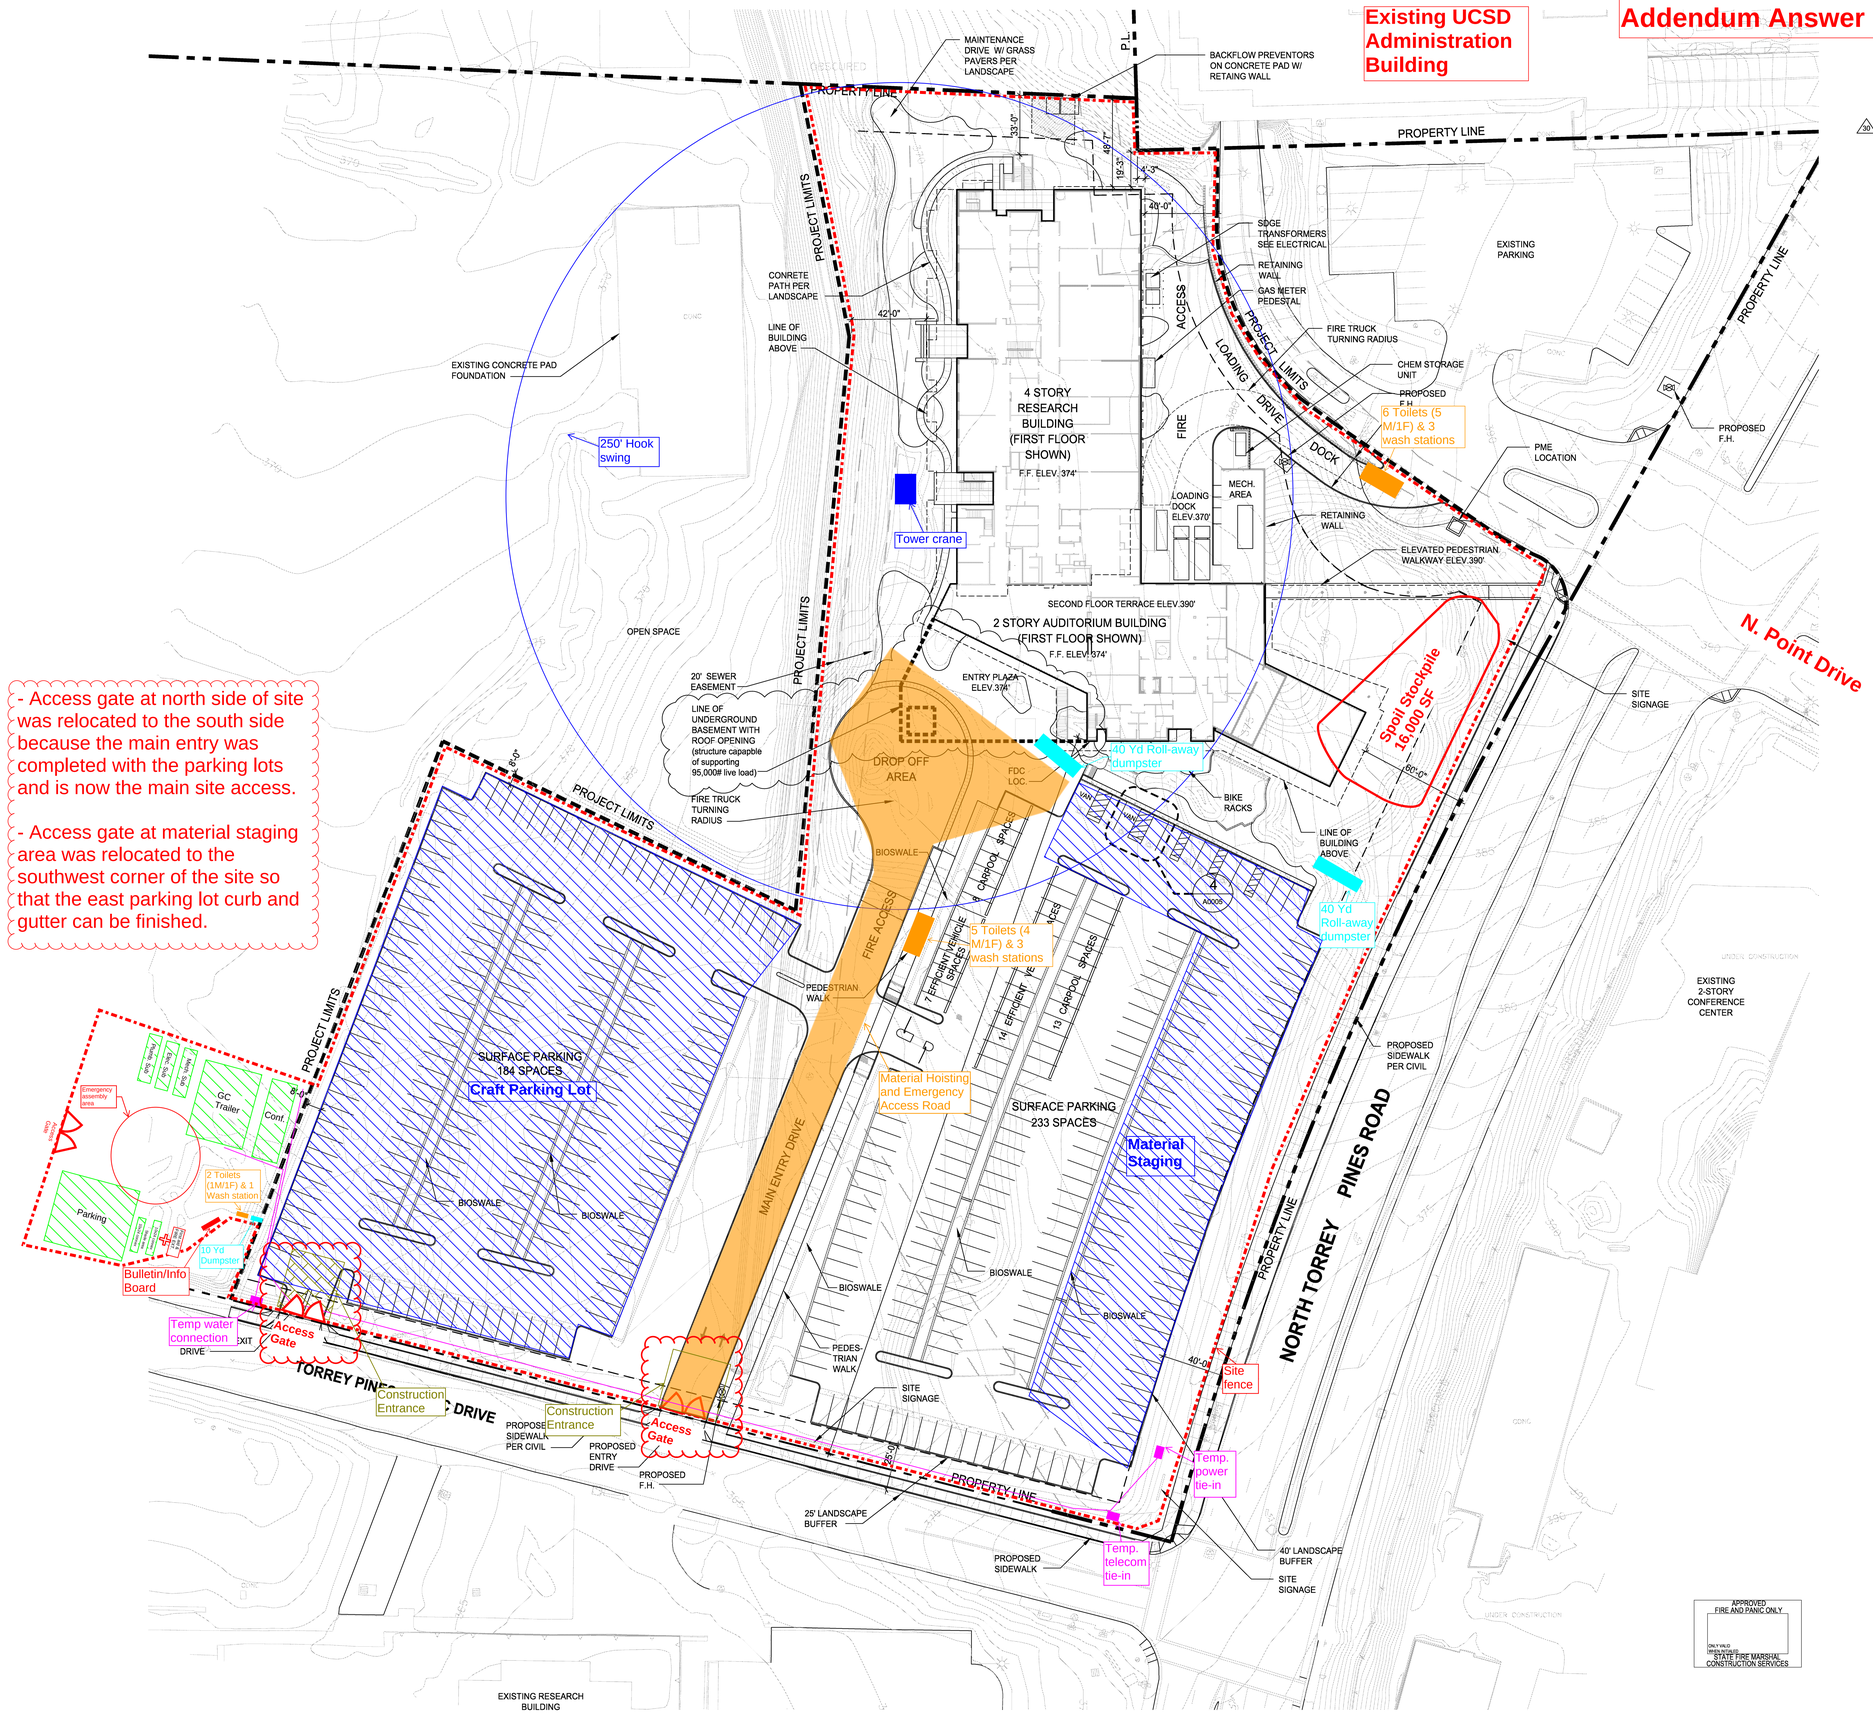

- Access gate at north side of site was relocated to the south side because the main entry was completed with the parking lots and is now the main site access.

- Access gate at material staging area was relocated to the southwest corner of the site so that the east parking lot curb and gutter can be finished.

1 SITE - OVERALL
PLAN A1101 1" = 30'

COPYRIGHT © FENTRESS ARCHITECTS

ISSUED FOR	DATE
BID PK #1 100 DD	10.06.08
50% PROGRESS	10.24.08
BD PK #1 80% CD	12.01.08
COAST. COMM.	01.09.09
BD PK #1 100 CD	02.16.09
BD PK #2 100 CD	03.29.09
100% CD	05.08.09
ADA REVIEW	08.26.09
CD-3	01.07.10
CD-4	05.10.10
~~ASI 008~~	~~12.15.10~~
30 CYCLOTRON	11.04.10

SANFORD CONSORTIUM FOR REGENERATIVE MEDICINE

La Jolla, CA

CONSULTANT

Lankford/Phelps Consortium LLC
655 West Broadway, Suite 1400 San Diego, CA 92101
619.702.8000 619.702.8001

FENTRESS | ARCHITECTS
421 Broadway, Denver, CO 80203
303|722|5000

STAMP

SHEET NAME: SITE PLAN

DRAWN BY: MEW

PROJECT #: 200725.000

SHEET NUMBER: A1101

1:114x2008 1:39:32 PM

Warning: It is a violation of the law for any person, unless acting under the direction of a licensed architect, to alter an item in any way. If an item in this document is altered, the altering architect, if other than the architect of record, shall affixto the item his seal and the notation "altered by" follows by his signiture and the date of such alteration, and the specific description of the alteration.