


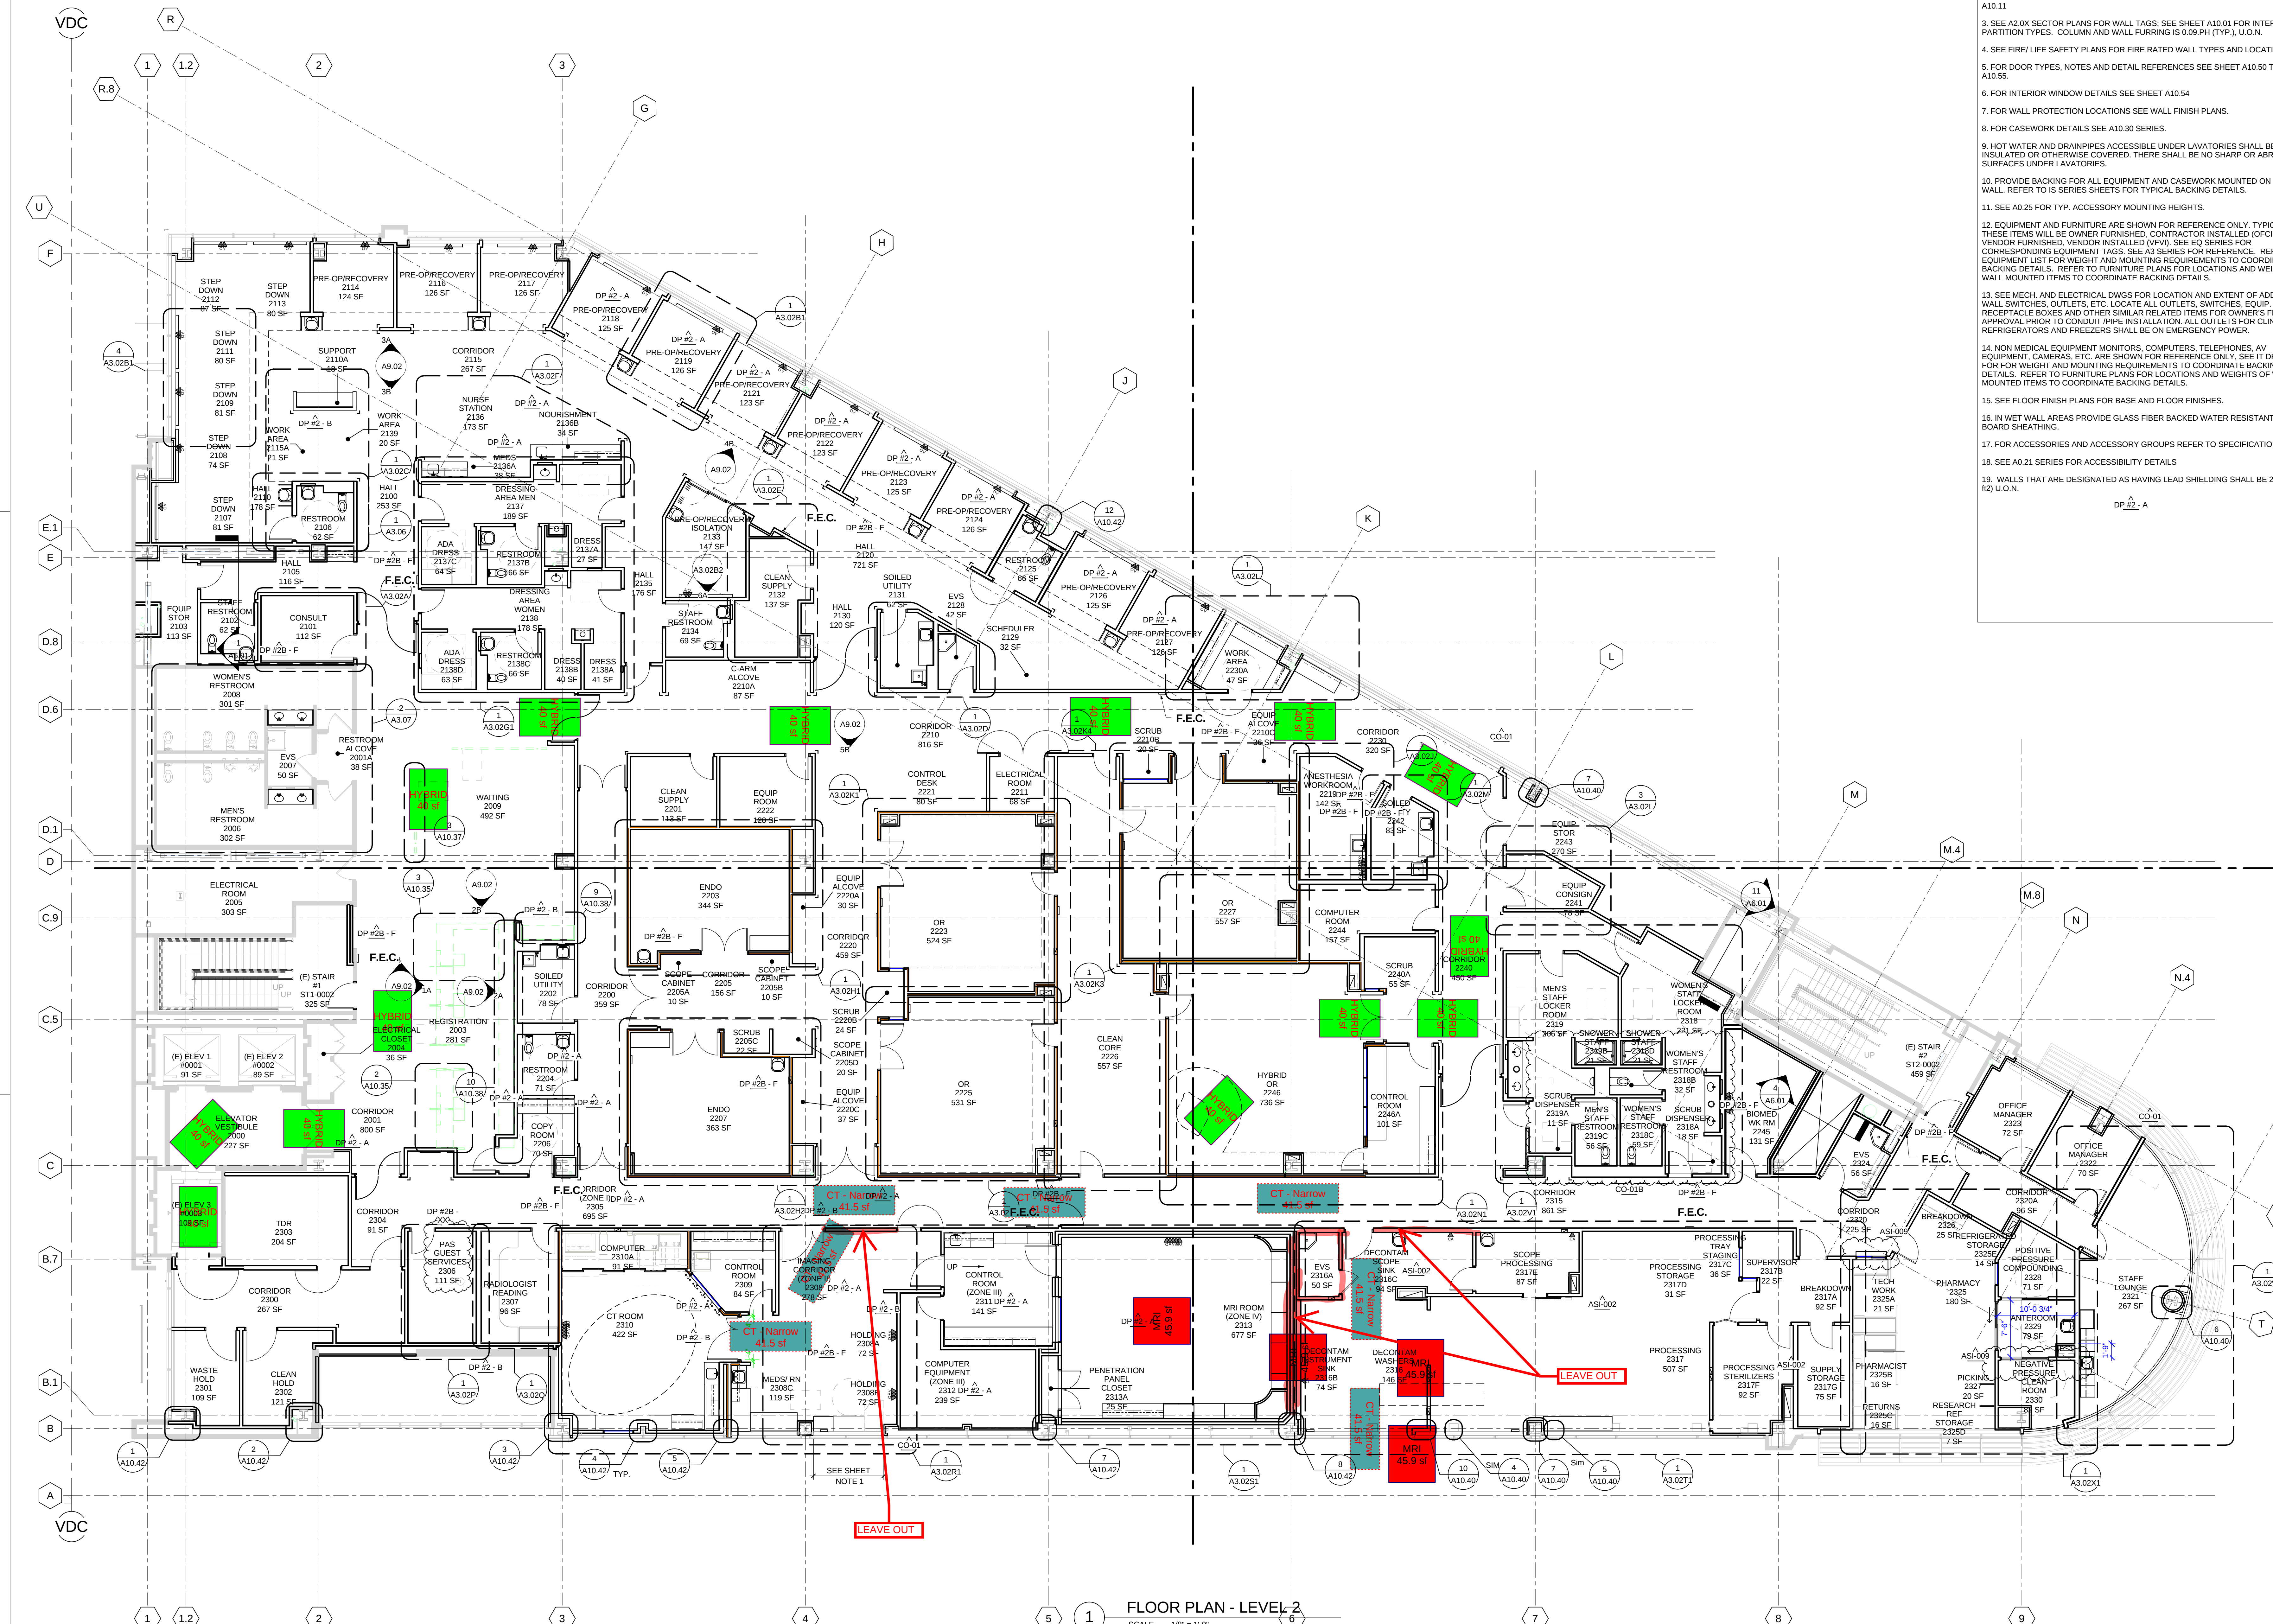

FLOOR PLAN - LEVEL 2
SCALE 1/8" = 1'-0"

GENERAL NOTES

- DIMENSIONS ARE TO FACE OF FINISH OR CENTERLINE OF COLUMN, U.O.N. DIMENSION STRINGS ARE STARTED AT STRUCTURAL GRIDLINES.
- FOR TYPICAL WALL FRAMING CONDITIONS AND DETAILING SEE SHEETS A10.00 - A10.11.
- SEE A2.0X SECTOR PLANS FOR WALL TAGS; SEE SHEET A10.01 FOR INTERIOR PARTITION TYPES. COLUMN AND WALL FURRING IS 0.09 PH (TYP.), U.O.N.
- SEE FIRE/LIFE SAFETY PLANS FOR FIRE RATED WALL TYPES AND LOCATIONS.
- FOR DOOR TYPES, NOTES AND DETAIL REFERENCES SEE SHEET A10.50 TO A10.55.
- FOR INTERIOR WINDOW DETAILS SEE SHEET A10.54.
- FOR WALL PROTECTION LOCATIONS SEE WALL FINISH PLANS.
- FOR CASEWORK DETAILS SEE A10.30 SERIES.
- HOT WATER AND DRAINPIPPES ACCESSIBLE UNDER LAVATORIES SHALL BE INSULATED OR OTHERWISE COVERED. THERE SHALL BE NO SHARP OR ABRASIVE SURFACES UNDER LAVATORIES.
- PROVIDE BACKING FOR ALL EQUIPMENT AND CASEWORK MOUNTED ON THE WALL. REFER TO IS SERIES SHEETS FOR TYPICAL BACKING DETAILS.
- SEE A0.25 FOR TYP. ACCESSORY MOUNTING HEIGHTS.
- EQUIPMENT AND FURNITURE ARE SHOWN FOR REFERENCE ONLY. TYPICALLY THESE ITEMS WILL BE OWNER FURNISHED. CONTRACTOR INSTALLED (OFCI). VENDOR FURNISHED. VENDOR INSTALLED (VFI). SEE EQ SERIES FOR CORRESPONDING EQUIPMENT TAGS. SEE A3 SERIES FOR REFERENCE. REFER TO EQUIPMENT LIST FOR WEIGHT AND MOUNTING REQUIREMENTS TO COORDINATE BACKING DETAILS. REFER TO FURNITURE PLANS FOR LOCATIONS AND WEIGHTS OF WALL MOUNTED ITEMS TO COORDINATE BACKING DETAILS.
- SEE MECH. AND ELECTRICAL DWGS FOR LOCATION AND EXTENT OF ADDITIONAL WALL SWITCHES, OUTLETS, ETC. LOCATE ALL OUTLETS, SWITCHES, EQUIP. RECEPTACLE BOXES AND OTHER SIMILAR RELATED ITEMS FOR OWNER'S FINAL APPROVAL PRIOR TO CONDUIT PIPE INSTALLATION. ALL OUTLETS FOR CLINICAL REFRIGERATORS AND FREEZERS SHALL BE ON EMERGENCY POWER.
- NON MEDICAL EQUIPMENT MONITORS, COMPUTERS, TELEPHONES, AV EQUIPMENT, CAMERAS, ETC. ARE SHOWN FOR REFERENCE ONLY. SEE IT DRAWINGS FOR WEIGHT AND MOUNTING REQUIREMENTS TO COORDINATE BACKING DETAILS. REFER TO FURNITURE PLANS FOR LOCATIONS AND WEIGHTS OF WALL MOUNTED ITEMS TO COORDINATE BACKING DETAILS.
- SEE FLOOR FINISH PLANS FOR BASE AND FLOOR FINISHES.
- IN WET WALL AREAS PROVIDE GLASS FIBER BACKED WATER RESISTANT WALL BOARD SHEATHING.
- FOR ACCESSORIES AND ACCESSORY GROUPS REFER TO SPECIFICATIONS.
- SEE A0.21 SERIES FOR ACCESSIBILITY DETAILS.
- WALLS THAT ARE DESIGNATED AS HAVING LEAD SHIELDING SHALL BE 2" (2lbs/ft²) U.O.N.

SHEET NOTES

- PROVIDE BRACING OF LOW PARTITION AT PERIMETER CURTAIN WALL:
A. WHERE SPAN IS LESS THAN 10'-6", USE DETAILS 2B/ AND 2C/A10.11.
B. WHERE SPAN IS GREATER THAN 10'-6", PROVIDE DOUBLE STUD BRACES PER DETAILS 2B/ AND 6A10.11.

KEY PLAN

NO.	DATE	ISSUED FOR

CERTIFIED BY

STANFORD HEALTH CARE
CENTER EMERYVILLE
5800 HOLLISS STREET
EMERYVILLE, CA 94608

PLAN CHECK#

PROJECT NO.

106-201

DATE

10/04/16

FLOOR PLAN - LEVEL 2

A2.02