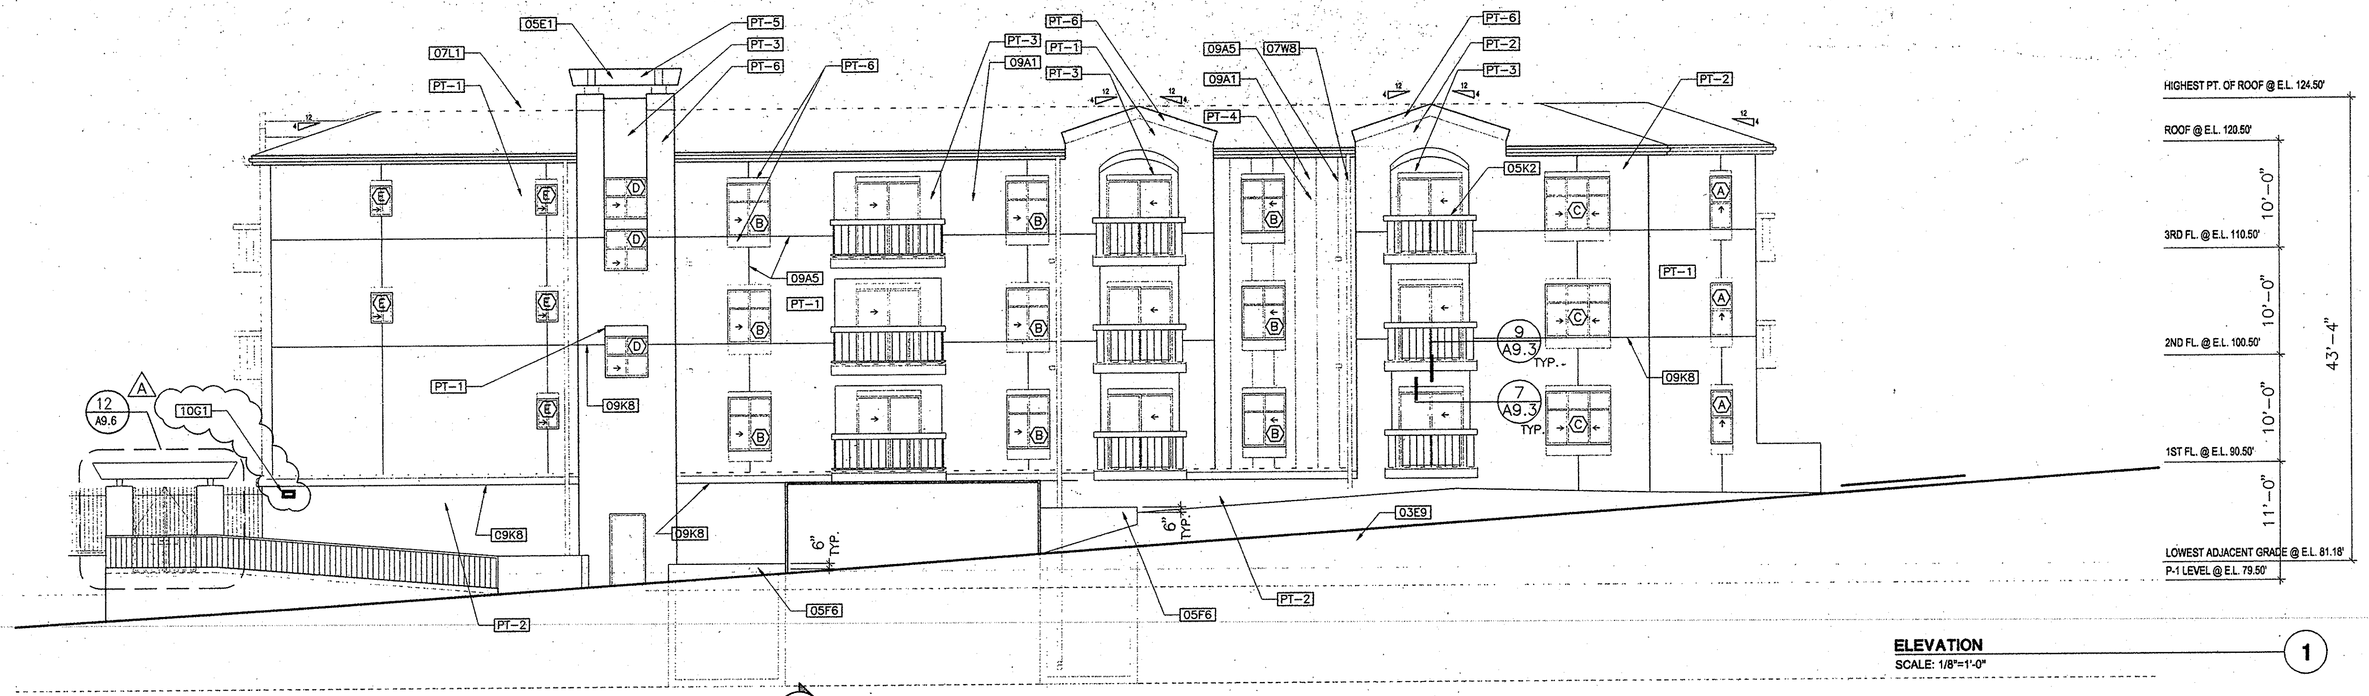

ELEVATION 1
SCALE: 1/8"=1'-0"

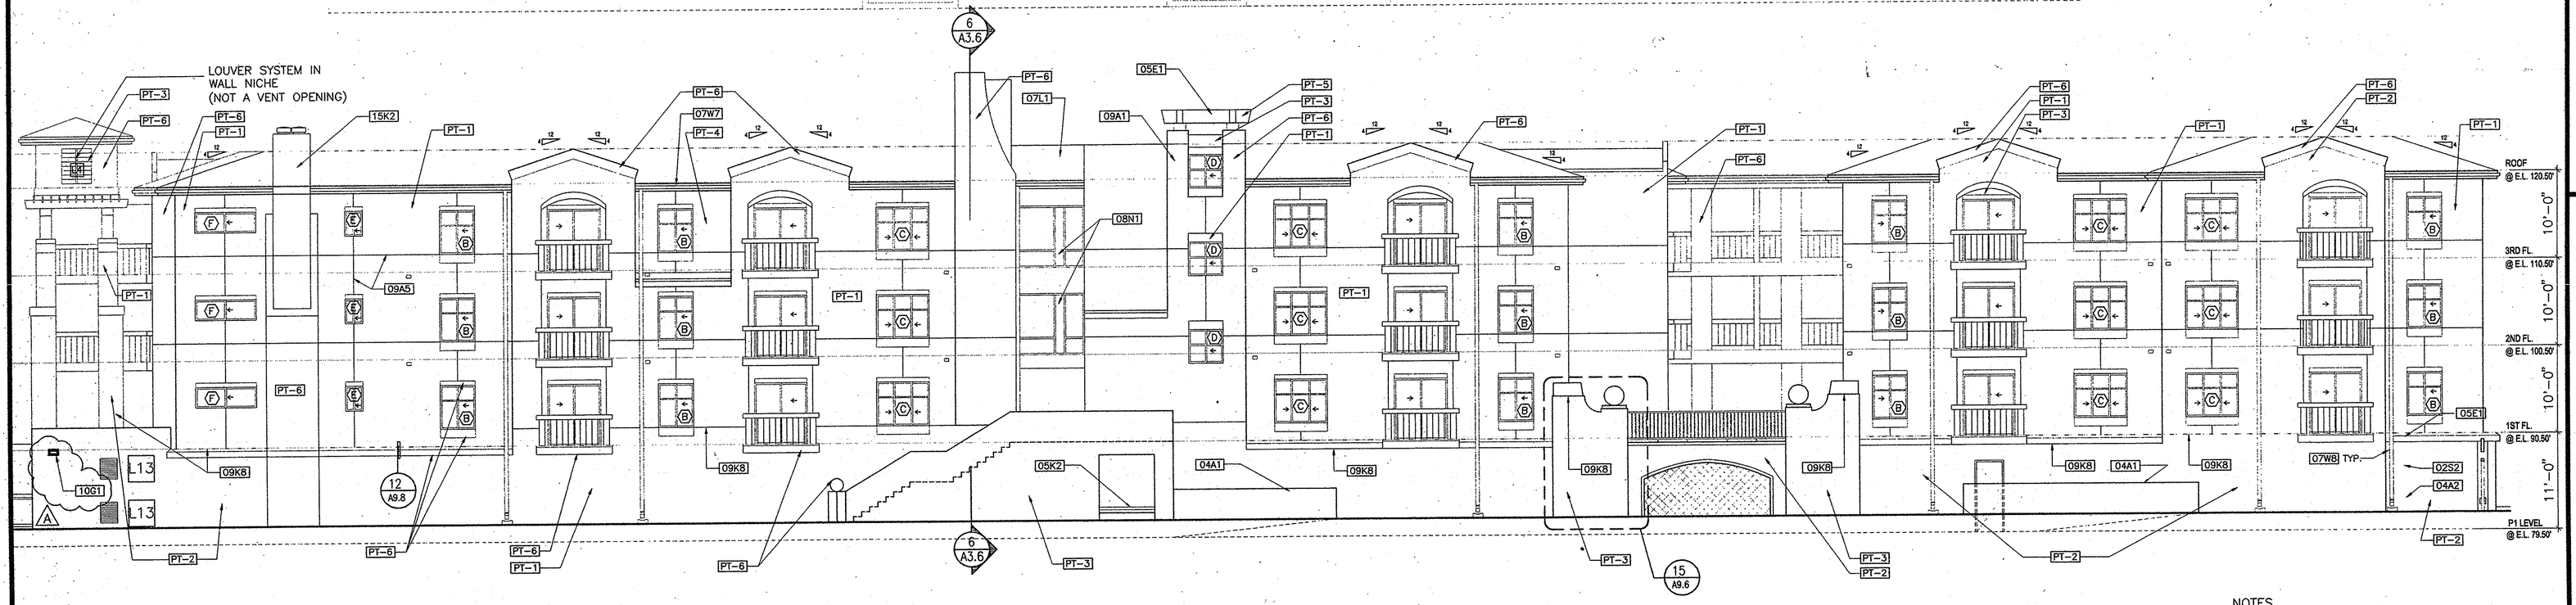

ELEVATION 2
SCALE: 1/8"=1'-0"

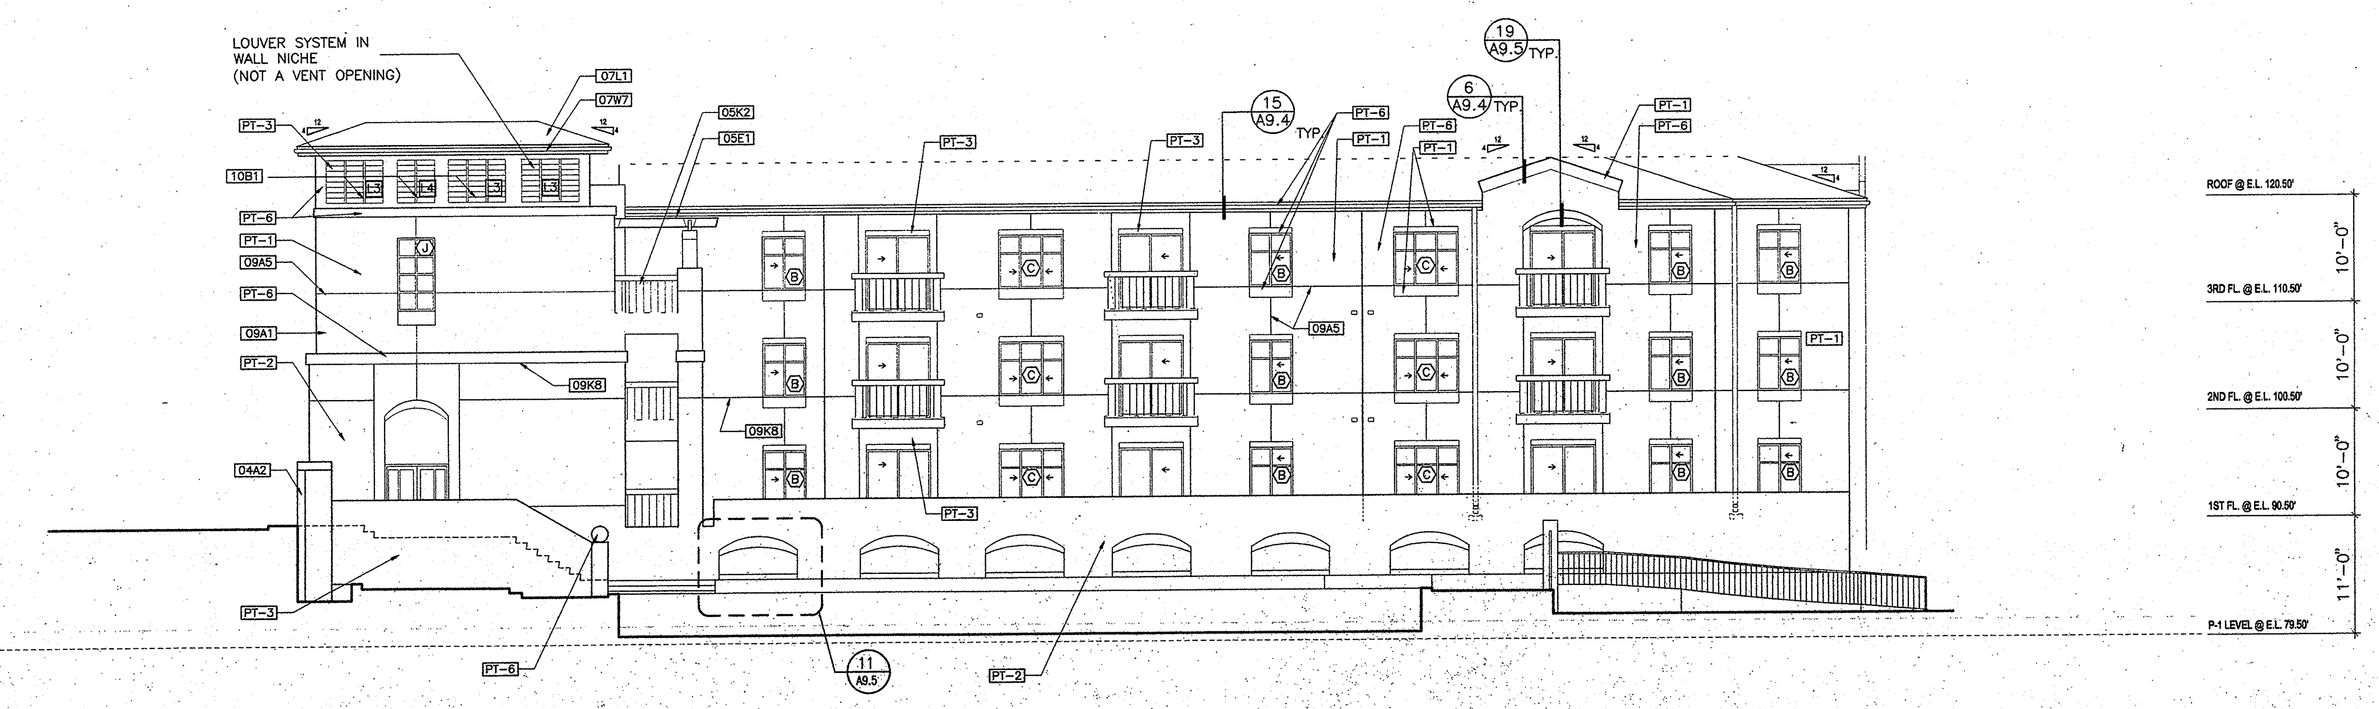

ELEVATION 3
SCALE: 1/8"=1'-0"

NOTES

1. PROVIDE ANTI-GRAFFITI COATING FROM FINISH GRADE TO LINE OF DEMARKATION INDICATED.

DRAWING KEYNOTE LEGEND

02S2	GATE- PAIR 5'-0"X8'-0" DECORATIVE IRON GATE
03E9	PRECAST CONCRETE SPLASHBLOCK
04A1	C.M.U. WALL (3'-0" HEIGHT)
04A2	C.M.U. RETAINING WALL
05E1	METAL FABRICATION ASSEMBLY - TRELLIS - 4,6-8/A9.4
05F6	WELDED STEEL BAR VENTILATION GRATE
05K2	ORNAMENTAL METAL RAILING - 3/A9.7
06H2	WOOD FASCIA, PRIMED AND PAINTED
07L1	CONCRETE ROOF TILE
07W7	GUTTER - 1, 15/A9.5
07W8	DOWNSPOUT LEADER
08N1	ALUMINIUM STOREFRONT SYSTEM
09A1	PORTLAND CEMENT PLASTER ASSEMBLY -8/A9.1
09A5	CONTROL JOINT - 9/A9.8
09K8	ANTI-GRAFFITI COATING
~~10B1~~	~~LOUVER VENT 16,17/A9.1~~
10G1	ADDRESS SIGNAGE
15K2	GAS APPLIANCE VENT TO ROOF
16B2	TRANSFORMER

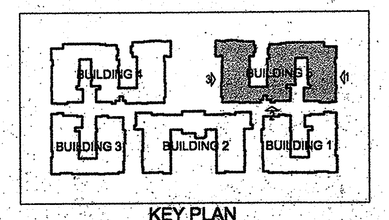

KEY PLAN

PENTHOUSE, 225 ARIZONA AVENUE
SANTA MONICA, CA 90401
TEL. 310.394.0273 FAX 310.394.2424

SUITE 170, 1600 BLAKE STREET
DENVER, CO 80202
TEL. 303.675.0041 FAX 303.675.0052

VAN TILBURG, BANVARD & SODERBERGH, AIA
ARCHITECTURE · PLANNING · INTERIORS

PLAYA DEL REY

8700 PERSHING DRIVE
PLAYA DEL REY, CALIFORNIA 90293

ARCHSTONE COMMUNITIES
217 Technology Drive, Second Floor
Irvine, California 92618

ISSUE	DATE	DESCRIPTION
	09.06.00	DESIGN DEVELOPMENT
	10.17.00	PROGRESS SET
	11.10.00	BUILDING DEPT. SUBMITTAL
	03.02.01	PROGRESS SET
	04.18.01	REVIEW SET
	06.28.01	REVIEW SET
	07.20.01	BID SET
A	10.05.01	GMAX SET

PROJECT: 9985
DRAWN: JT
CHECKED:

BUILDING FIVE:
EXTERNAL ELEVATIONS

A5.5