


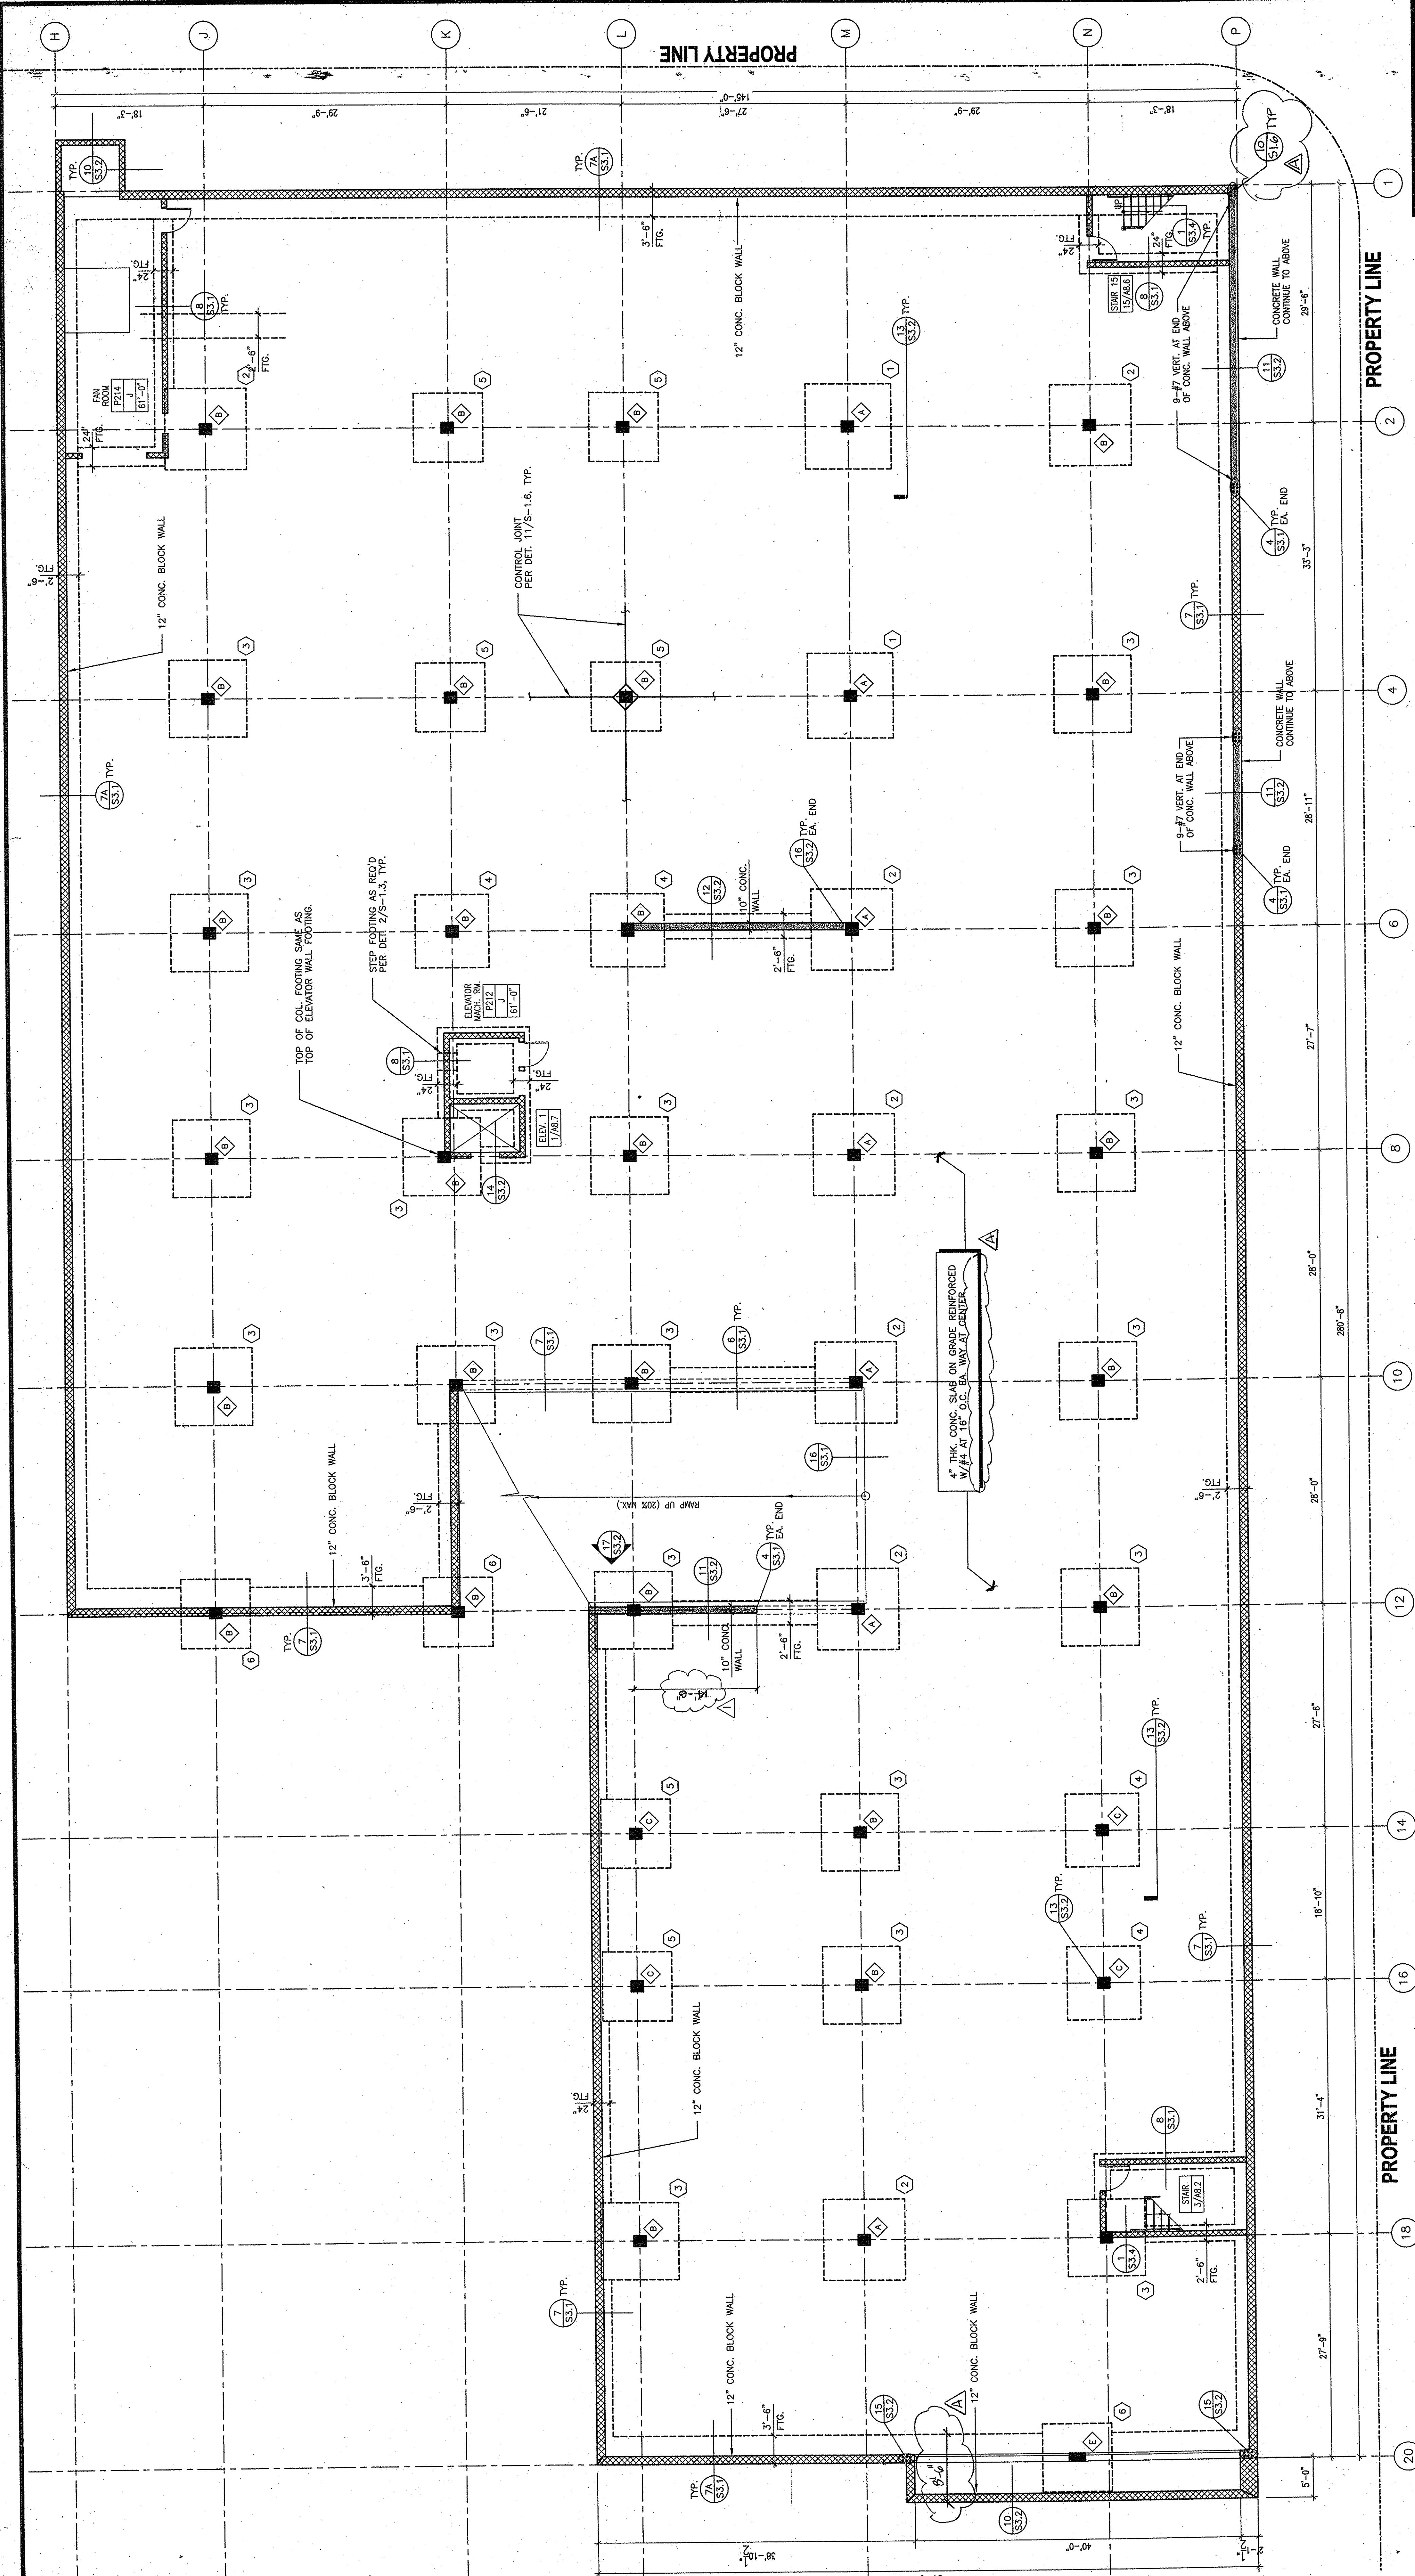

FOUNDATION PLAN - SOUTHEAST GARAGE PLAN (LEVEL P2) 1
SCALE: 1/8" = 1'-0"

BRIAN L. COCHRAN ASSOCIATES, INC.
CONSULTING STRUCTURAL ENGINEERS
2040 ARMADOST AVE. LOS ANGELES CA 90025
(310) 207-6600 FAX (310) 207-0100


ISSUE	DATE	DESCRIPTION
08.18.00	PROGRESS & REVIEW SET	
09.06.00	DESIGN DEVELOPMENT SET	
10.17.00	50% CD	
11.10.00	BIDG. DEPARTMENT SUBMITAL	
03.08.01	PLAN CHECK RESUBMITAL	
06.26.01	BID SET	
10.05.01	OMAX SET	

PROJECT:	9985
DRAWN:	C.C.
CHECKED:	B.B.
FOUNDATION PLAN	
LEVEL P2	
SOUTHEAST GARAGE	



S-2.1

PLAYA DEL REY
8700 PERSHING DRIVE
PLAYA VISTA, CALIFORNIA 90293

ARCHSTONE COMMUNITIES TRUST
8801 Wall Street, Suite 800
Austin, Texas 78754

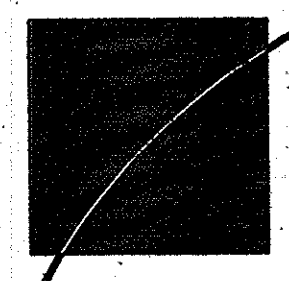

VAN TILBURG, BANVARD & SODERBERGH, AIA
ARCHITECTURE - PLANNING - INTERIORS

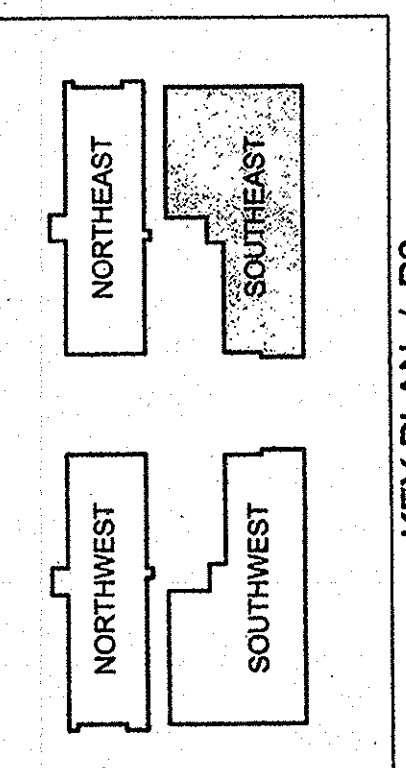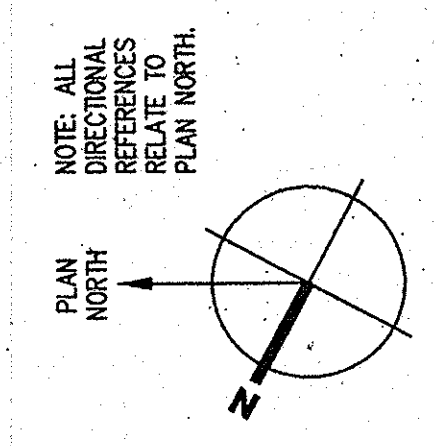

KEY PLAN / P2

WALLS SHALL NOT BE BACKFILLED UNTIL THE STRUCTURAL SLAB ACHIEVES ITS REQ'D. STRENGTH.

FOUNDATION NOTES:

- FOR TOP OF CONCRETE SLAB ELEVATION, SEE ARCH'L DRAWINGS. VERIFY ALL DIMENSIONS AND ELEV. WITH ARCH'L DWGS.
- ① DENOTES FOOTING TYPE, FOR SIZE AND REINFORCING SEE FOOTING SCHEDULE.
- TOP OF FOOTING ELEVATION IS 24" MINIMUM BELOW FINISH GRADE UNLESS NOTED OTHERWISE ON PLAN.
- ④ DENOTES COLUMNS TYPE, FOR SIZE AND REINF. SEE 3/S-3.1
- FOR SLAB ON GRADE DETAILS SEE 1/S-1.3
- FOR STEP FOOTING DETAILS SEE 2/S-1.3
- FOR STEPS ON GRADE DETAILS SEE 3/S-1.3
- VERIFY LOCATION AND DEPTH OF ALL SLAB DEPRESSIONS WITH ARCHITECTURAL DRAWINGS.
- FOR STAR DETAILS SEE S-3.3

SPREAD FOOTING SCHEDULE		
FOOTING TYPE	FTG. SIZE	REINFORCING 5% MIN BOTTOM
①	10'-6" x 10'-6"	30" 14-#7
②	10'-0" x 10'-0"	30" 12-#7
③	9'-6" x 9'-6"	28" 12-#7
④	9'-0" x 9'-0"	26" 10-#7
⑤	8'-6" x 8'-6"	25" 9-#7
⑥	8'-0" x 8'-0"	24" 8-#7
⑦	7'-6" x 7'-6"	23" 10-#6
⑧	7'-0" x 7'-0"	21" 9-#6